


KANSAS

Sedgwick

Section 5 Township 28 Range 2E

Well No. #1 Boyle

Company Beech Aircraft et al

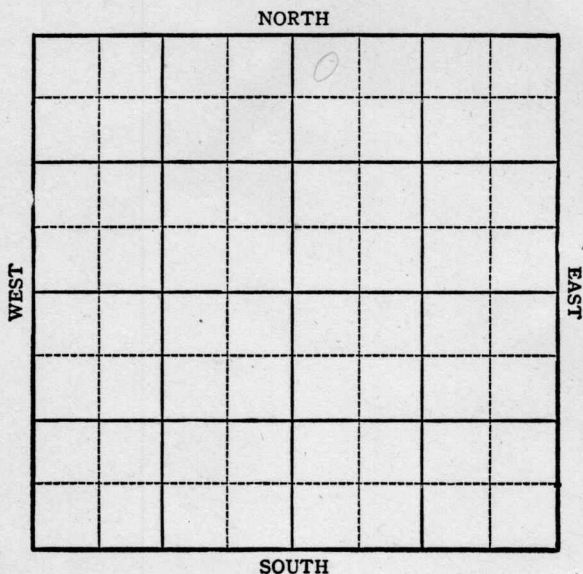

KANSAS

Sedgwick County

Sec. 5 Twp. 28 R. 2E

Well No. #1 Boyle Farm

Beech Aircraft etal. Company


Misc.

330 Ft. from N. Line

Ft. from S. Line

Ft. from E. Line

330 Ft. from W. Line

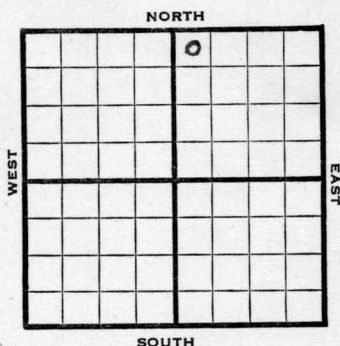

NW NE

6 lev. 1391

REPORT

1944

8/16	Loc.
8/23	Cable Rig.
8/30	Spud
9/8	15" @ 115 Drlg. 400
9/13	Drlg. 1085
9/21	1" @ 1200 Drlg. 1805
9/28	Lans 2233
	Drlg. 2275
10/4	Kc 2550
	TD 2665 RUST
10/11	8" @ 2670
	Miss 3019
	Drlg. 3025
10/18	Drlg. 3245
10/25	Viola 3344
	Arb 3445
	TD 3454

ABANDONED

KANSAS


Pool Name MiscellaneousMap No. 12 Sec. 5 Twp. 28 R. 2EWell No. 1 BoyleBeech Aircraft etal. Company

FIRST REPORT

Contractor

NW NE

SECTION PLAT

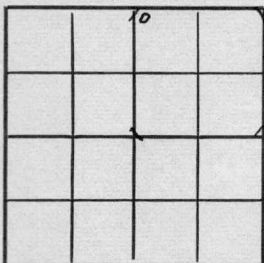330 Ft. from N. Line Ft. from S. Line Ft. from E. Line330 Ft. from W. Line

Sedgwick County

Location XRig up

Drilling and Remarks:

RECORD

Cased in., ft.Sand Gas Oil Total Depth

PRODUCTION

1st 24 hrs. Nat. 1st 24 hrs. after shot Gas Cu. Ft.Dry Hole Abandoned

Date

AUG 16 1944

19

S. J. LEWIS

Scout

Pool Name MiscellaneousMap No. KANSAS Sec. 5 Twp. 28 R. 2EWell No. 1 BoyleBeech Aircraft etal. CompanyABANDONED

Contractor

NW NE

SECTION PLAT

		o	

330 Ft. from N. Line

Ft. from S. Line

Ft. from E. Line

330 Ft. from W. LineSedgwick County

Location _____

Rig up _____

Drilling and Remarks:

*Vidla 3344**Ar 33445*

RECORD

Cased _____ in., _____ ft.

Sand _____

Gas _____

Oil _____

Total Depth 3454

PRODUCTION

1st 24 hrs. Nat. _____

1st 24 hrs. after shot _____

Gas _____ Cu. Ft.

Dry Hole _____

Abandoned _____

Date

OCT 25 1944 19S. J. LEWIS Scout