


Section 32 Township 28 Range 1 E
Well No. # 1 Williams Unit
Ryan Community-
Company O. A. Sutton & Gabbert-Jones

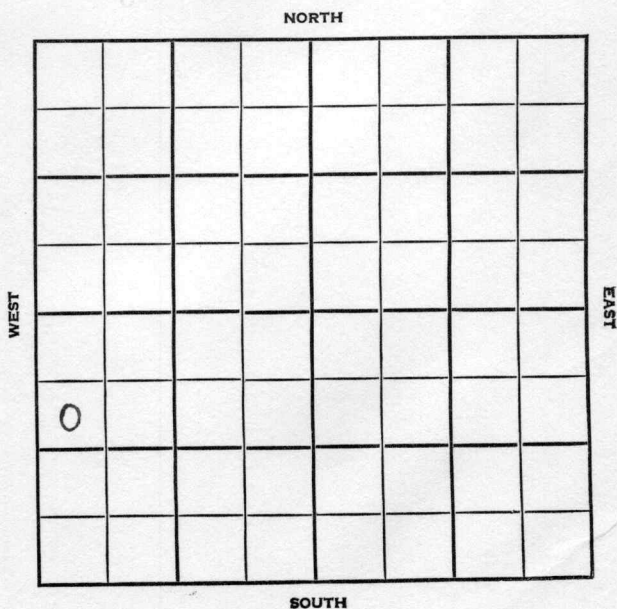

Sedgwick KANSAS

SEC.	TWP.	R.
32	28	1E

WELL NO.

~~1 Ryan Community~~
WILLIAMS UNIT

FARM

COMPANY

O. A. Sutton + GABBERT-JONES

CONTRACTOR

Gabbert-Jones

Glays Pool

990


Ft. from N. Line

Ft. from S. Line

Ft. from E. Line

330

Ft. from W. Line

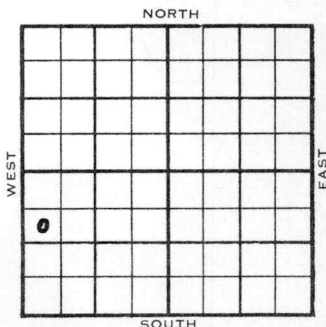

SW NW SW

1955

ELEVATION

1264'

REPORT

3/16

Spud 3-11-55

8" @ 140'

WOC

8/3


DST 3172-90 open 1 hr. gas in 50 min.
 Rec. 30' vsocm 1125# DST 3200-08 open
 1 hr. gas in 20 min. Rec. 160' oil 60'
 ocm 30' wtr. 1230# TD 3248 5½" @ 3248/1
 100 CO to 3240 8/3201-03 S/60 bo 195
 bsw 16 hr. CO to 3211 16/3201-03 S/1
 go 1½ gwph 500 A S/25 bo 60 bw 8 hr.
 CO 28/3173-80, 1000 A 2,000 mcfg SP
 3190 250A F/32 boph 1 hr. F/81 bo 50
 bw 11 hr. Comp. 62 bopd 25% wtr.

M. 3156 1892

M. Dolo. 3172 1908

TD. 3190

COMPLETED

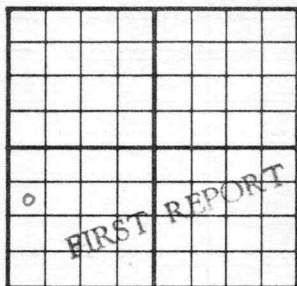County Sedgwick State KANSASSec. 32 (Blk.) 28 (Sur.) 1E Map No.Operator O. A. SuttonWell No. 1 Farm Ryan CommunityElev. Location SW NW SW990 Ft. From N Line SW330 Ft. From W Line Quarter1st. Report MAR 16 1955

Completion

Remarks

Gabbert-Jones - Contr.Spudding Date 3-11-55Drig. Data Gladys Pool8" @ 140 WOC

FABEN GILSTRAP

SCOUT TICKET

DX-201

Kansas

SEC.

TWP.

R.

32

28

1E

WELL NO.

1 Williams Unit

FARM

COMPANY

O.A. Sutton & Gabbert-Jones

CONTRACTOR

CORRECTION

SW NW SW


990 FT. FROM N. LINE

FT. FROM S. LINE

FT. FORM E. LINE

330 FT. FROM W. LINE

NORTH

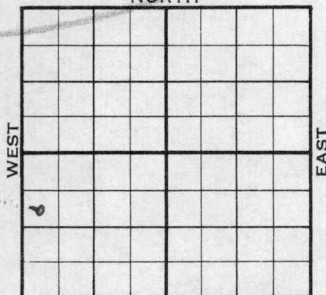

SOUTH

Sedgwick County

☐

LOCATION

☐

RIG UP

DRILLING AND REMARKS:

Reported

O.A. Sutton

#1 Ryan Community

RECORD

CASED IN., FT.

SAND

GAS

OIL

TOTAL DEPTH

1ST 24 HRS. NAT.

1ST 24 HRS. AFTER SHOT

GAS CU. FT.

DRY HOLE

ABANDONED

PRODUCTION

DATE

MAR 23 1955

SCOUT

FABEN GILSTRAP

County Sedgwick Elev. 1264Sec. 32 Twp. 28 Rge. 1ECompany O. A. SuttonFarm Name Williams Unit No. 1

TOPS

DEPTH

LOG

DATUM

Loc. in Sec.

Anh.

T.P.

H.

Tr.

Dg.

B.L.

L.

K.C.

B.K.C.

Ce.

C.

M.

M.

K.

Mz.

Mq.

V.

S.

S.

A.

R.

P.C.

G.

G.

T.D.

SW NW NW

Geol.

Contr.

Gabbert Jones

Pool

Gladys

Date Comm. 3-7-55 AUG 3 1955

8" @ 145/150 DST 3172-90 open 1 hr.

Gas in 50 min. Rec. 30' vsocm 1125#

DST 3200-08 open 1 hr. gas in 20 min.

Rec. 160' oil 60' ocm 30' wtr.

1230# TD 3248 5½" @ 3248/100

CO to 3240 8/ 3201-03 S/ 60 bo

195 bsw 16 hr. CO to 3211

16/ 3201-03 S/ 1 go 1½ gwph 500 A

S/ 25 bo 60 bw 8 hr. CO 28/ 3173-80
1000 A 2,000 mcfg SP 3190 250 A
F/ 32 boph 1 hr. F/ 81 bo 50 bw 11 hr.
Comp. 62 bopd 35% wtr.

Scout Cards	
Land Small Map	
Land Wall Map	
Tracings	
France Map	
Pierce Map	
Misc.	

[Handwritten signature]

AUG 10 1955