

KANSAS


Sedgwick

FORM 51 5M PETROL

Section 3 Township 28 Range 2-E


Well No. #1 Streiff

Company Beech Aircraft

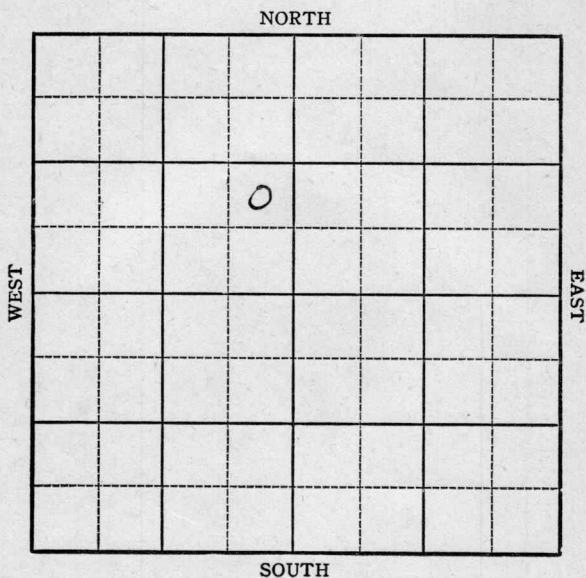

Sec. 3 Twp. 28 R. 2-EWell No. #1 Streiff FarmBeech Aircraft Company

NORTH

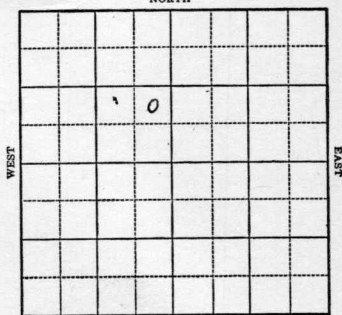

SOUTH

           Ft. from N. Line990 Ft. from S. Line330 Ft. from E. Line           Ft. from W. LineElev. 1361

1943

## R E P O R T

|       |                                                                 |
|-------|-----------------------------------------------------------------|
| 11/3  | Location                                                        |
| 11/10 | "                                                               |
| 11/17 | "                                                               |
| 12/22 | Cable rig.                                                      |
| 12/29 | 120' SD for 15"                                                 |
| 1944  |                                                                 |
| 1-5   | 15" @ 120<br>Drlg 375'                                          |
| 1-12  | TD 750<br>Run 12½"                                              |
| 1/19  | 12" @ 753<br>Drlg. 1570'                                        |
| 1/26  | 10" @ 2080<br>Drkg. 2100'                                       |
| 2/2   | 10" @ 11505<br>Topeka 2180<br>Lans 2180<br>KC 2151<br>8" @ 2685 |
| 2/8   | Miss 2986<br>B. Miss 3251<br>Drlg. 3275                         |
| 2/16  | Miss 3010<br>Simp 3308<br>TD 3340                               |

ABANDONED

KANSAS

Map No. 72 Sec. 3 Twp. 28 R. 2EWell No. 1 StreiffBeech Aircraft Company

FIRST REPORT

Contractor

NE SE NW

## SECTION PLAT

|  |   |  |  |
|--|---|--|--|
|  |   |  |  |
|  | 0 |  |  |
|  |   |  |  |
|  |   |  |  |
|  |   |  |  |

Ft. from N. Line

990 Ft. from S. Line330 Ft. from E. Line

Ft. from W. Line

Wildcat

Location X

Rig up

Drilling and Remarks:

## RECORD

Cased \_\_\_\_\_ in., \_\_\_\_\_ ft.

Sand \_\_\_\_\_

Gas \_\_\_\_\_

Oil \_\_\_\_\_

Total Depth \_\_\_\_\_

## PRODUCTION

1st 24 hrs. Nat. \_\_\_\_\_

1st 24 hrs. after shot \_\_\_\_\_

Gas \_\_\_\_\_ Cu. Ft.

Dry Hole \_\_\_\_\_

Abandoned \_\_\_\_\_

Date

NOV 3 1943 19S. J. LEWIS Scout

Map No. KANSAS 2 Sec. 3 Twp. 28 R. 2E

Well No. 1 Streiff

Beech Aircraft Company

ABANDONED Contractor

NE SE NW

SECTION PLAT

|  |   |  |  |
|--|---|--|--|
|  |   |  |  |
|  | o |  |  |
|  |   |  |  |
|  |   |  |  |

           Ft. from N. Line

990 Ft. from S. Line

330 Ft. from E. Line

           Ft. from W. Line

**Wild cat**

Location                                 

Rig up                                 

Drilling and Remarks:

*Miss 3010*  
*Snip 3308*

RECORD

Cased            in.,            ft.

Sand                                 

Gas                                 

Oil                                 

Total Depth 3340

PRODUCTION

1st 24 hrs. Nat.                                 

1st 24 hrs. after shot                                 

Gas                                  Cu. Ft.

Dry Hole                                 

Abandoned                                 

Date

FEB 16 1944 19 S. J. LEWIS Scout