

# KANSAS


Form 51—5M—11-38—Palace

Sedgwick

Section 4 Township 28 Range 2-E


Well No. 1 Fields

Company Cameron & Spencer

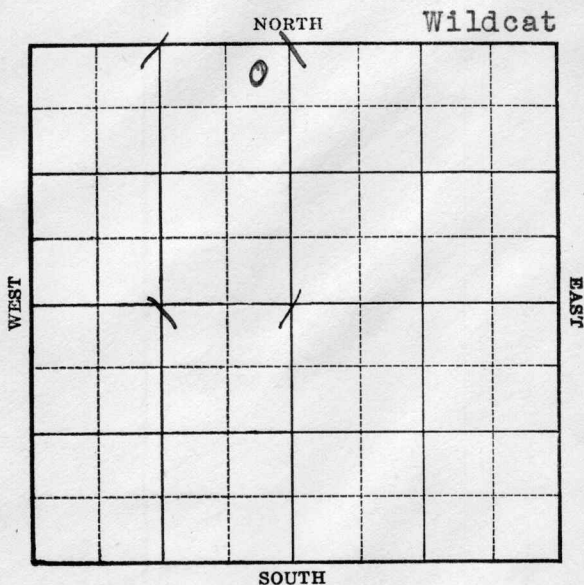

Sec. 4 Twp. 28 R. 2-EWell No. #1 Fields FarmCameron & Spencer Company

(Wildcat)

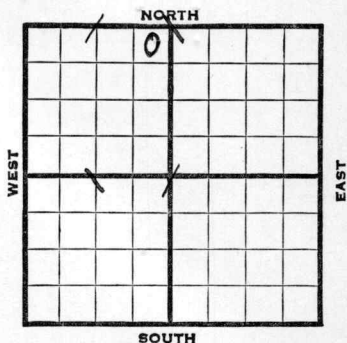330 Ft. from N. Line       Ft. from S. Line330 Ft. from E. Line       Ft. from W. LineElev. 1385

| 1939 | REPORT                  |
|------|-------------------------|
| 3/8  | Mat'l.                  |
| 3/17 | RUCT.                   |
| 3/24 | "                       |
| 3/31 | "                       |
| 4/7  | S.D.                    |
| 4/14 | "                       |
| 4/21 | "                       |
| 4/28 | "                       |
| 5/5  | "                       |
| 5/12 | "                       |
| 5/19 | "                       |
| 5/26 | "                       |
| 6/1  | "                       |
| 6/8  | "                       |
| 6/16 | "                       |
| 7/6  | Cable rig. 320'         |
| 7/13 | " "                     |
| 7/20 | " "                     |
| 7/27 | Spud.                   |
| 8/3  | 15" - 140' Drlg. 850'   |
| 8/10 | 12" - 1088' Drlg. 1755' |

OVER

|       |                  |              |       |
|-------|------------------|--------------|-------|
| 1939  |                  |              |       |
| 8/17  | 10" - 1945'      | Drlg.        | 2585' |
| 8/24  | K. C. 2516'      | 8" - 2640'   |       |
|       | T.D. 2670'       | SD.          |       |
| 8/31  | " "              | "            |       |
| 9/7   | " "              | "            |       |
| 9/14  | " "              | "            |       |
| 9/21  | " "              | "            |       |
| 9/28  | Miss. 2988'      | HFW at 3007' | SD.   |
| 10/5  | 6" - 2988'       | C.O.         |       |
| 10/11 | Simp. sand 3296' |              |       |
|       | T.D. 3312'       |              |       |
|       | H.F.W.           |              |       |


ABANDONED

Sedgwick **KANSAS**Map No. 12 Sec. 4 Twp. 28 R. 2EWell No. 1 FieldsCameron & Spencer Company

Contractor

**FIRST REPORT**

NE NW

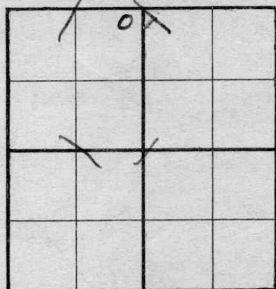330 Ft. from N. Line       Ft. from S. Line330 Ft. from E. Line       Ft. from W. Line**WILDCAT****SECTION PLAT**Location                                 Rig up                                 

Drilling and Remarks:

**MATL.****RECORD**Cased            in.,            ft.Sand                                 Gas                                 Oil                                 Total Depth                                 **PRODUCTION**1st 24 hrs. Nat.                                 1st 24 hrs. after shot                                 Gas                                  Cu. Ft.Dry Hole                                 Abandoned                                 

Date

MAR 8 - 1939

19

H. D. Hatfield Scout

Sedgwick

KANSAS

Map No. 12 Sec. 4 Twp. 28 R. 2EWell No. 1 FieldsCameron & Spencer

Company


Contractor

ABANDONED

NE NW

330 Ft. from N. Line       Ft. from S. Line330 Ft. from E. Line       Ft. from W. Line

## SECTION PLAT

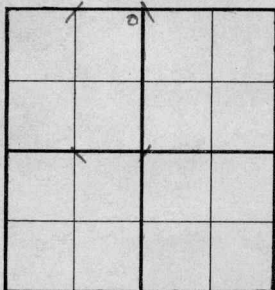

WILDCAT

Location                                 Rig up                                 

Drilling and Remarks:

*Simp Sand 3296**HFW.*

## RECORD

Cased            in.,            ft.Sand                                 Gas                                 Oil                                 Total Depth 3312

## PRODUCTION

1st 24 hrs. Nat.                                 1st 24 hrs. after shot                                 Gas                                  Cu. Ft.Dry Hole                                 Abandoned                                 

Date

OCT 11 1939 19S. J. LEWIS Scout