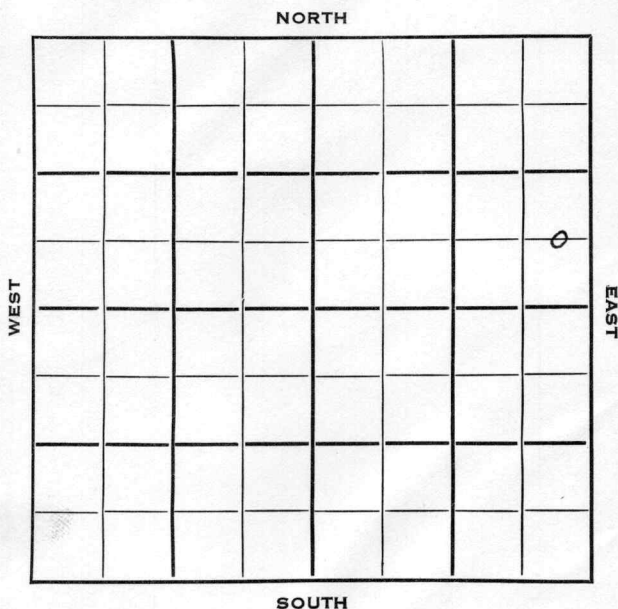


Section 4 Township 28 Range 2EWell No. #1 HurstCompany J. P. Gaty

Sedgwick
28

KANSAS ✓
2E

Sec. 4 Twp. R.

Well No. #1 Hurst Farm

J. P. Gaty Company


Morrison Drlg.
Wildcat Contractor

Ft. from N. Line

660 Ft. from S. Line

330 Ft. from E. Line

Ft. from W. Line

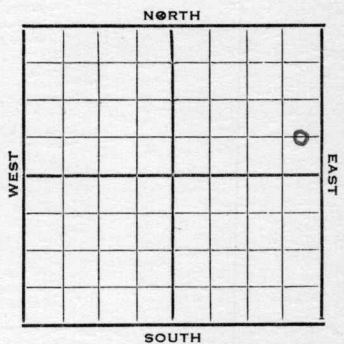


C E L S E N E

1953 Elev. - REPORT

2/25 Drlg. 440'

3/4 KC 2502, Marm 2730, Miss
2978
TD 3080
D&A

ABANDONED

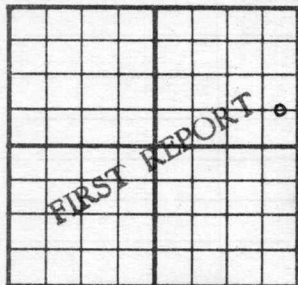County Sedgwick State KansasSec. 4 (Blk.) 28 (Sur.) 2E Map No.Operator J. P. GatyWell No. 1 Farm HurstElev. Location C E L S E N E660 Ft. From S Line NE330 Ft. From E Line Quarter1st. Report FEB 25 1953


Completion

Remarks

Morrison Drlg. - Contr.

Spudding Date

Drlg. Data Wildcatdrlg. 440

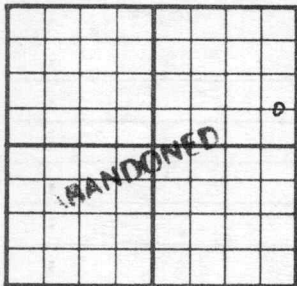County Sedgwick State KansasSec. 4 (Blk.) 28 (Sur.) 2E Map No.Operator J. P. GatyWell No. 1 Farm HurstElev. Location C E L S E N E660 Ft. From S Line NE330 Ft. From E Line Quarter1st. ReportCompletion MAR 4 1953Remarks WildcatMorrison Drlg. - Contr.Spudding DateDrlg. DataKC 2502 Marm. 2730 Miss. 2978 TD 3080D & A