


Map No. K Sec. 15 Twp. 24 R. 12
Well No. J Johnson Farm
Franklin Oil Company

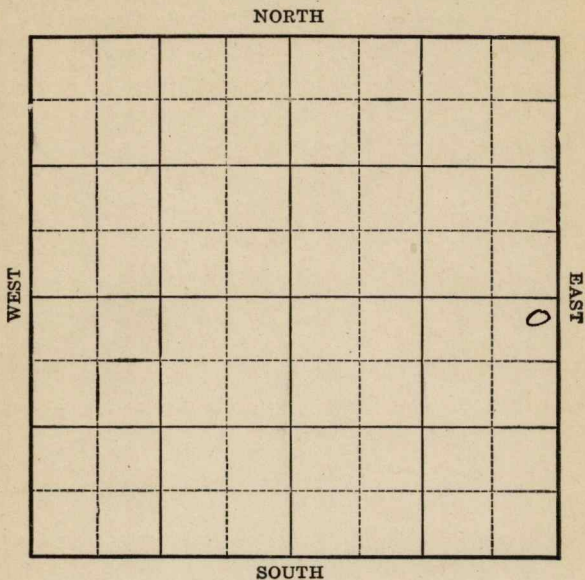

Location _____

Drilling Remarks:

RECORD

Cased _____ in. _____ ft.

Sand _____

Gas _____

Oil _____

Total Depth _____

Rig Up _____

Drilling Remarks:

PRODUCTION

1st 24 hrs. Nat. _____

1st 24 hrs. after shot _____

Gas _____ cu. ft.

Dry Hole _____

Abandoned _____


Map No. K Sec. 15 Twp. 24 R. 12
 Well No. L- Johnson Farm
Franklin del Company

200 Ft. from N. Line

_____ Ft. from S. Line

200 Ft. from E. Line

_____ Ft. from W. Line

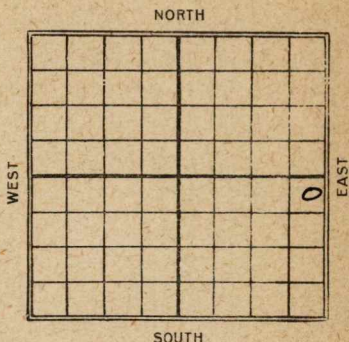

Date

REPORT

1921
4/2 Machine

4/24 Sand 1707-38 Swabbing
 75 Bbls

5/22 Top 1707-

Pay - 1707-38

Swabbed. 75 Bbls net

Map No. **KANSAS** *16* Sec. *15* Twp. *24* R. *12*Well No. *1 - Johnson**Franklin Oil* Company

Contractor

FIRST REPORT

SECTION PLAT

200' Ft. from N. Line

Ft. from S. Line

200' Ft. from E. Line

Ft. from W. Line

			0

Location

Rig up

Drilling and Remarks:

machine

RECORD

Cased _____ in., _____ ft.

Sand _____

Gas _____

Oil _____

Total Depth _____

PRODUCTION

1st 24 hrs. Nat. _____

1st 24 hrs. after shot _____

Gas _____ Cu. Ft.

Dry Hole _____

Abandoned _____

Date

APR 2 1924

M. A. BENEAR

192 Scout

Map No. **KANSAS** Sec. *15* Twp. *24* R. *12*

Well No. *1 Johnson*
Franklin Oil Company

Contractor

COMPLETED SECTION PLAT

200 Ft. from N. Line

_____ Ft. from S. Line

200 Ft. from E. Line

_____ Ft. from W. Line

			<i>6</i>

Location _____

Rig up _____

Drilling and Remarks:

Log 1707
Pay 1707-38
Swapped
75 lb. m.

RECORD

Cased _____ in., _____ ft.

Sand _____

Gas _____

Oil _____

Total Depth _____

PRODUCTION

1st 24 hrs. Nat. _____

1st 24 hrs. after shot _____

Gas _____ Cu. Ft.

Dry Hole _____

Abandoned _____

Date

MAY 22 1924

M. A. BENEAR

192

Scout