

Sec. 15 Twp. 24 Range 12E

#1 Johnson

Kansas Geological Society

Franklin

Skelly Scout Tickets

Map No. K Sec. 15 Twp. 24 R. 12


Well No. 1-Johnson Farm
Franklin Oil Company

_____ Ft. from N. Line

1120 Ft. from S. Line

200 Ft. from E. Line

_____ Ft. from W. Line

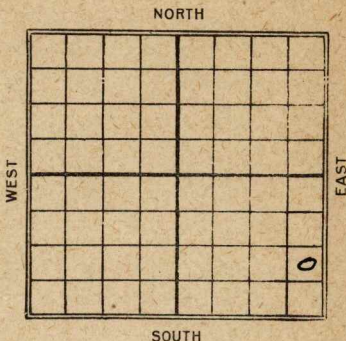

Date 1924

REPORT

6/10 Machine
7/9 Top Line 1741
 Run 1768-88
 1007 50 Bbls

Map No. 76 **KANSAS** Sec. 15 Twp. 24 R. 12Well No. #1 Johnson
Franklin oil Company

Contractor

FIRST REPORT

SECTION PLAT

Ft. from N. Line

1120 Ft. from S. Line200 Ft. from E. Line

Ft. from W. Line

Location

Rig up

Drilling and Remarks:

mark

RECORD

Cased _____ in., _____ ft.

Sand _____

Gas _____

Oil _____

Total Depth _____

PRODUCTION

1st 24 hrs. Nat. _____

1st 24 hrs. after shot _____

Gas _____ Cu. Ft.

Dry Hole _____

Abandoned _____

Date

JUN 10 1924

M. A. BENEAR

192

Scout

Map No. **16** **KANSAS** Sec. **15** Twp. **24** R. **12**

Well No. **1** **Johnson**

Franklin Oil Company

Contractor

COMPLETED

SECTION PLAT

_____ Ft. from N. Line

1120 Ft. from S. Line

200 Ft. from E. Line

_____ Ft. from W. Line

			0

Location _____

Rig up _____

Drilling and Remarks:

Tap L. 1741

Pay 1768-85

100/30 Hb

RECORD

Cased _____ in., _____ ft.

Sand _____

Gas _____

Oil _____

Total Depth _____

PRODUCTION

1st 24 hrs. Nat. _____

1st 24 hrs. after shot _____

Gas _____ Cu. Ft.

Dry Hole _____

Abandoned _____

Date

JUL 9 1924

M. A. BENEAR

192

Scout