

CONTROL KANSAS

Section 15 Township 24 Range 12E

Well No. 4 Johnson

Company Skelly

Virgil Pool
NORTH

NORTH

WEST

EAST

SOUTH

HOT FILE

Greenwood

Sec. 15 Twp. 24 R. 12E ✓

Well No. #4 Johnson Farm

Skelly

Company

Virgil Pool


1170' Ft. from N. Line

Ft. from S. Line

Ft. from E. Line

1080' Ft. from W. Line

SE NW SE

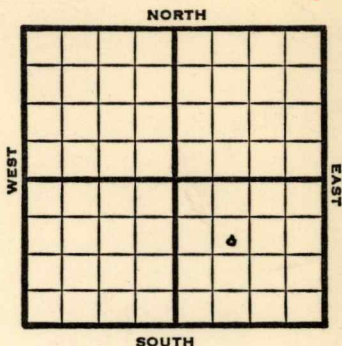

1949

Elev 1062'

R E P O R T

2/16

Drlg. 85'

2/23

"

3/2

8" @ 1259'

Drlg. 1610'

3/8

Miss 1689'

Drlg 1693'

3/16

TD 1709'

Miss 1689'

5" @ 1691'

2000 acid

Pump 63 Oil / 32 W Pot

38.0 Gr.

Comp

COMPLETED

Map No. _____ Sec. 15 Twp. 24 R. _____

Well No. 4 Johnson

Skelly Company

FIRST REPORT Contractor

SE NW SE


SECTION PLAT

1170 Ft. from N. Line

_____ Ft. from S. Line

_____ Ft. from E. Line

1080 Ft. from W. Line

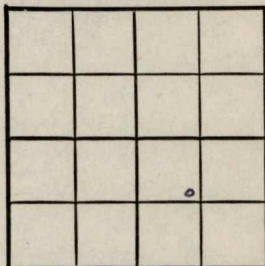

Greenwood County

Location _____

Rig up _____

Drilling and Remarks:

drlg. 85

RECORD

Cased _____ in., _____ ft.

Sand _____

Gas _____

Oil _____

Total Depth _____

PRODUCTION

1st 24 hrs. Nat. _____

1st 24 hrs. after shot _____

Gas _____ Cu. Ft.

Dry Hole _____

Abandoned _____

Date

FEB 16 1949

19

S. J. LEWIS

Scout

Kansas

Virgil Pool

Map No. K 16 Sec. 15 Twp. 24 R. 12EWell No. 4 JohnsonSkelly

Company


COMPLETE

Contractor

SE NW SE

E 11062

SECTION PLAT

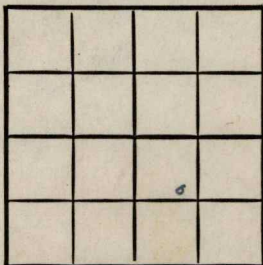1170 Ft. from N. Line Ft. from S. Line Ft. from E. Line1080 Ft. from W. Line

Greenwood County

Location Rig up

Drilling and Remarks:

Max 16895' @ 16912000 acidRun 63 oil + 32HBD38°/hr

RECORD

Cased in., ft.Sand Gas Oil Total Depth 1709

PRODUCTION

1st 24 hrs. Nat. 1st 24 hrs. after shot Gas Cu. Ft.Dry Hole Abandoned

Date

MAR 16 1949

19

S. J. LEWIS

Scout