

EAST

SOUTH

[illegible]

Cased _____ in _____ ft.
 Sand _____
 Gas _____
 Oil _____
 Total Depth _____

[illegible]

1st 24 hrs. Nat. _____
1st 24 hrs. after shot _____
Gas _____ cu. ft. _____
Dry Hole _____
Abandoned _____

Map No. KANSAS Sec. 11 Twp. 28 R. 2E

Well No. 1- Jansen Farm


T. C. Johnson Company

 Ft. from N. Line

330 Ft. from S. Line

 Ft. from E. Line

330 Ft. from W. Line

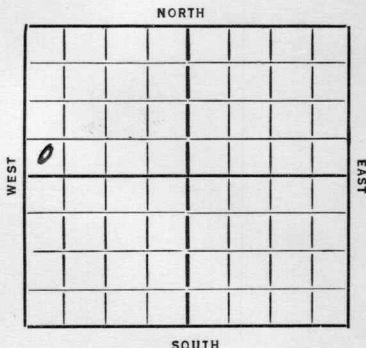

REPORT

~~1/19/6~~
 1/8 Location
 1/17
 1/24 B.C.
 1/31 Ru
 2/7
 2/14 Spent 115
 2/21 SD 385
 2/28 Wg 1160
 3/6 " 1370 12" 738
 3/13 10"-2148 T.D. 2340 S.D.
 3/20 Drlg. 2940.
 3/27 T. Miss. 2975' 8"- 2975' Small
 show of oil. 2975-79' Misner 3290-
 94' S.W. Viola 3294'-3305'. Wilcox
 3305' Drlg. 3340' HFW.
 4/1 Sil 3370
 TD 3404
 D. & A.

ABANDONED

Map No. 12 Sec. 11 Twp. 28 R. 2 E

Well No. 1- Janssen

T. C. Johnson Company

Contractor

SECTION PLAT

.....Ft. from N. Line

330 Ft. from S. Line

.....Ft. from E. Line

330 Ft. from W. Line

0			

FIRST REPORT

Location.....

Rig up.....

Drilling and Remarks:

RECORD

Cased.....in.,ft.

Sand.....

Gas.....

Oil.....

Total Depth.....

PRODUCTION

1st 24 hrs. Nat.....

1st 24 hrs. after shot.....

Gas.....Cu. Ft.

Dry Hole.....

Abandoned.....

Date

JAN 8 1936

192

ORVAL MANNSCHRECK

Scout

Map No. 12 Sec. 11 Twp. 28 R. 2E

Well No. 1- Jansen

TC Johnson Company

Contractor

ABANDONED

SECTION PLAT

0			

Ft. from N. Line

330 Ft. from S. Line

Ft. from E. Line

330 Ft. from W. Line

Location

Rig up

Drilling and Remarks:

10 + 7

RECORD

Cased in, ft.

Sand Sil 3370

Gas

Oil

Total Depth 3404

PRODUCTION

1st 24 hrs. Nat.

1st 24 hrs. after shot

Gas Cu. Ft.

Dry Hole

Abandoned

Date

4-1-36 192 Scout

ORVAL MANNSCHRECK