


Section 9 Township 28 Range 4E
Well No. 2 West
Company Murfin Drlg.

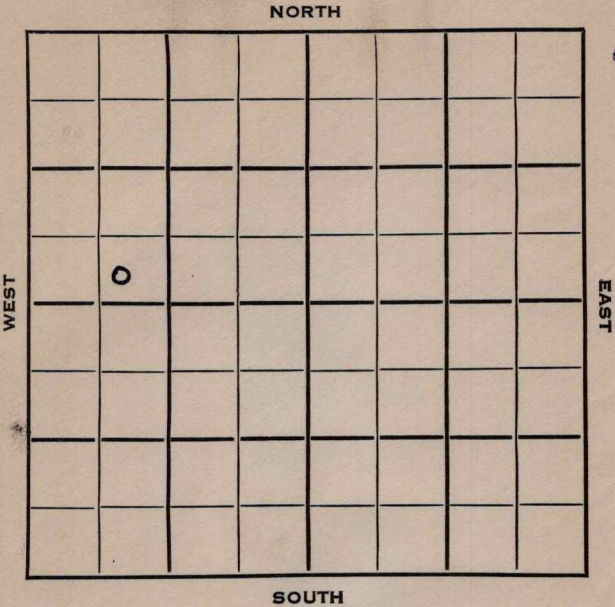

Butler

KANSAS

SEC. 9	TWP. 28	R. 4E
-----------	------------	----------

WELL NO.

#2 West

FARM

COMPANY

Murfin Drlg.

CONTRACTOR

Murfin Drlg.

Augusta Pool

2375


Ft. from N. Line

Ft. from S. Line

Ft. from E. Line

800

Ft. from W. Line

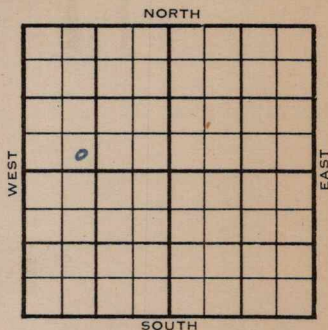

SE SW NW

1954	ELEVATION 1208'	REPORT
------	--------------------	--------

1/6 RUCT
2/3 Spud 1-7-54
D & A
TD 2625'
10" @ 1575'
Simp 2 407'
TD 2625'
7" @ 2520'
HFW
D & A

ABANDONED

County Butler State KansasSec. 9 (Blk.
Twp.) 28 (Sur.
Rge.) 4E Map No.Operator Murfin Drlg.Well No. 2 Farm WestElev. 1208 Location SE SW NW2375 Ft. From N Line NW800 Ft. From W Line Quarter

1st. Report

Completion FEB 3 1954Remarks Augusta PoolMurfin Drlg. - Contr.Spudding Date 1-7-54Drlg. Data D & A TD 262510" @ 1575 Simp. 2407 TD 26257" @ 2520 HFWD & A