

E

WEST

EAST

SOUTH

Rig Up _____

Drilling Remarks:

PRODUCTION

1st 24 hrs. Nat. _____

1st 24 hrs. after shot_____

Gas _____ cu. ft.

Dry Hole _____

Total Depth_____


Abandoned _____

Map No. K Sec. 14 Twp. 28 R. 2^EWell No. 1 Landon Farm
Merriman Company

Ft. from N. Line

300 Ft. from S. Line300 Ft. from E. Line

Ft. from W. Line

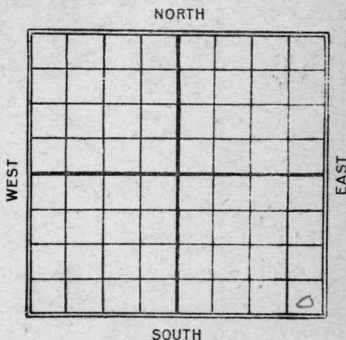

Date

REPORT

192410/8 Rig up11/26 Sh @ 1900'12/17 Shaw Bas 2558-18FW

sh 6" 2735 D. 2800'

19251/2119251/21 Sh 30906/2 Well Complete8/7192610/6 I.D. 3541-D. 8 A.

K12 Sedg. Co. 14
Map No. **KANSAS** Sec. 14 Twp. 28 R. 2 E

Well No. 1 Landon

Merriam Company

Contractor

FIRST REPORT**SECTION PLAT**

			0

Ft. from N. Line

300' Ft. from S. Line

300' Ft. from E. Line

Ft. from W. Line

Location

Rig up ✓ ✓

Drilling and Remarks:

RECORD

Cased _____ in., _____ ft.

Sand _____

Gas _____

Oil _____

Total Depth _____

PRODUCTION

1st 24 hrs. Nat. _____

1st 24 hrs. after shot _____

Gas _____ Cu. Ft.

Dry Hole _____

Abandoned _____

Date

OCT 8 1924

192

M. A. BENEAR

Scout

Map No. KANSAS Sec. 14 Twp. 28 R. 27

Well No. 1 Sanclum

Merriman & Co. Company

Contractor

SECTION PLAT

			o

_____ Ft. from N. Line

300 Ft. from S. Line

300 Ft. from E. Line

_____ Ft. from W. Line

ABANDONED

Location _____

Rig up _____

Drilling and Remarks:

7213541

7817

RECORD

Cased _____ in., _____ ft.

Sand _____

Gas _____

Oil _____

Total Depth _____

PRODUCTION

1st 24 hrs. Nat. _____

1st 24 hrs. after shot _____

Gas _____ Cu. Ft.

Dry Hole _____

Abandoned _____

Date

OCT 6 1926

S. J. LEWIS

192

Scout

MAP No. K12 SEC. 14 TWP. 78S R. 2EWELL No. 1 LondonE. B. Merriam

COMPANY

CONTRACTOR

SECTION PLAT

			0

____ Ft. FROM N. LINE

____ Ft. FROM S. LINE

____ Ft. FROM E. LINE

____ Ft. FROM W. LINE

*we show 35 41
not changing*

RECORD

LOCATION _____

CASED _____ IN. _____ FT.

RIG UP _____

SAND _____

DRILLING AND REMARKS:

GAS _____

OIL _____

TOTAL DEPTH 3530

PRODUCTION

1ST 24 HRS. NAT. _____

1ST 24 HRS. AFTER SHOT _____

GAS _____ Cu. Ft.

DRY HOLE ☒ABANDONED ☒

DATE

3/4 5

192

SCOUT

*2970 Top
line show
oil
3280 } H 2. N
3303 }*