


Sedgwick
 Form 51-5M-11-31-Palace
 Map No. KANSAS Sec. 13 Twp. 28 R. 2E
 Well No. 1-London Farm
W.A. Cameron Company

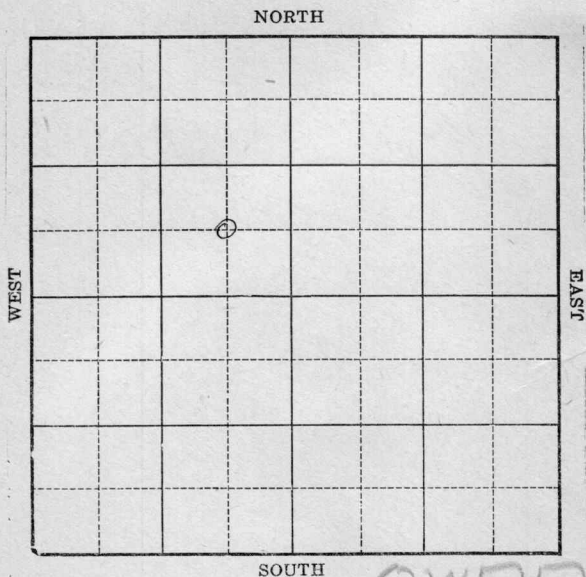

Location _____

Drilling Remarks _____

Rig Up _____

Drilling Remarks _____

RECORD

Cased _____ in. _____ ft.

Sand _____

Gas _____

Oil _____

Total Depth _____

PRODUCTION

1st 24 hrs. Nat. _____

1st 24 hrs. after shot _____

Gas _____ cu. ft.

Dry Hole _____


Abandoned _____

Hedgwick
2A-5M-8-30-PETROL

Map No. **KANSAS** Sec. 13 Twp. 28 R. 2^E

Well No. 1-London Farm
W.A. Cameron Company

NORTH

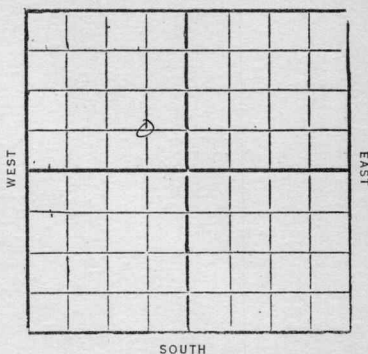

 Ft. from N. Line

660 Ft. from S. Line

660 Ft. from E. Line

 Ft. from W. Line

1932

Date

REPORT

<u>5/4</u>	<u>Loc</u>
<u>5/11</u>	<u>Bldg rig</u>
<u>5/18</u>	<u>Rig</u>
<u>5/25</u>	<u>—</u>
<u>6/1</u>	<u>—</u>
<u>6/8</u>	<u>Ran up</u>
<u>6/15</u>	<u>Spud 850</u>
<u>6/22</u>	<u>—</u>
<u>6/29</u>	<u>Spdg 200'</u>
<u>7/6</u>	<u>—</u>
<u>7/13</u>	<u>Drlg 700'</u>
<u>7/20</u>	<u>10"-1480'</u>
<u>7/27</u>	<u>SD 1480'</u>
<u>8/3</u>	<u>Drlg 2010' HFW</u>
<u>8/10</u>	<u>SD 2010'</u>
<u>8/17</u>	<u>set 8"-2010'</u>
	<u>Cly out</u>
<u>8/24</u>	<u>TD 2525' fishing</u>
<u>8/31</u>	<u>—</u>
<u>9/7</u>	<u>—</u>
<u>9/14</u>	<u>Drlg 2725'</u>
	<u>(over)</u>

9/21- 6"-2622
 Top Chat 2950
 SD 2975
 9/30- TD 2975 VIR 6"
 10/5 —
 10/12 —
 10/14- Chat 2950-80
 TD 2995 VIR 6"
 10/26- 6"-2990
 drlg 3080' lime
 11/2- 6"-2997
 Rng 5"-3130'
 11/9- HFW 3254 in sand
 drlg 3264'
 11/16- VIR 5"-3269
 11/23- drlg 3275 sand
 11/30- Top Chelic lime 3303
 HFW 3312
 drlg 3330'
 12/7- " 3434
 12/14- " 3484 lime
 12/21- Top Chelic lime 3303
 HFW 3312
 TD 3516
 Abandoned
 1932 OWDD
 12/28- Old TD 3516
 Will deepen
 1933
 1/4 —
 1/11- TD 3531 Rig burned
 1/18- SD 3531'

Map No. Kansas Sec. 13 Twp 28 R. 2^E
Well No. 1- Landon Farm
W.A. Cameron Company


 Ft. from N. Line

660 Ft. from S. Line

660 Ft. from E. Line

 Ft. from W. Line

1933

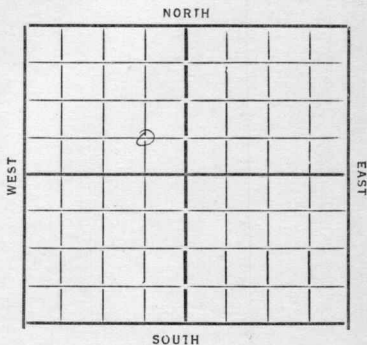

Date

REPORT

OWDD

1/25

Top Zelic Line 3303

TD 3531

Dry & Abandoned

12 KANSAS

Map No. Sec. 13 Twp. 28 R. 2

Well No. 1 Landow

N. a. Cameron Company

Contractor

FIRST REPORTS

Ft. from N. Line

660 Ft. from S. Line

660 Ft. from E. Line

Ft. from W. Line

SECTION PLAT

	0		

Location ✓

Rig up

Drilling and Remarks:

RECORD

Cased in., ft.

Sand

Gas

Oil

Total Depth

PRODUCTION

1st 24 hrs. Nat.

1st 24 hrs. after shot

Gas Cu. Ft.

Dry Hole

Abandoned

Date

MAY 4 1932 CHAS. L. SHERWOOD

192 Scout

12 KANSAS Sec. 13 Twp. 28 R. 2 E

Well No. 1 Ranger
W. a. Cameron Company

Contractor

COMPLETED

SECTION PLAT

Ft. from N. Line

660 Ft. from S. Line

660 Ft. from E. Line

Ft. from W. Line

ABANDONED

Location

Rig up

Drilling and Remarks:

Top Dilicams
3303

HFW 3317

RECORD

Cased in, ft.

Sand

Gas

Oil

Total Depth 3516

PRODUCTION

1st 24 hrs. Nat.

1st 24 hrs. after shot

Gas Cu. Ft.

Dry Hole ✓

Abandoned ✓

Date

DEC 2 1 1932

192

CHAS. L. SHERWOOD

Scout

12 KANSAS Sec. 13 Twp. 28 R. 2 E

Well No. 1 Landon
N. A. Cameron Company

Contractor

FIRST REPORTS

Ft. from N. Line

660 Ft. from S. Line

660 Ft. from E. Line

Ft. from W. Line

SECTION PLAT

11 0 11 11			

Location

Rig up

Drilling and Remarks:

pld T.D. 3516

Will Deepen

RECORD

Cased in., ft.

Sand Top S. 11 3303

Gas

Oil

Total Depth

PRODUCTION

1st 24 hrs. Nat.

1st 24 hrs. after shot

Gas Cu. Ft.

Dry Hole

Abandoned

Date

DEC 23 1932

CHAS. L. SHERWOOD

192

Scout

12 KANSAS

Map No. _____ Sec. 13 Twp. 28 R. 2

Well No. 1

N. a. Cameron Company

Contractor

COMPLETED

SECTION PLAT

Ft. from N. Line

660 Ft. from S. Line

660 Ft. from E. Line

Ft. from W. Line

ABANDONED

Location _____

Rig up _____

Drilling and Remarks:

Top Dili ceaus
3303

RECORD

Cased _____ in., _____ ft.

Sand _____

Gas _____

Oil _____

Total Depth 3531

PRODUCTION

1st 24 hrs. Nat. _____

1st 24 hrs. after shot _____

Gas _____ Cu. Ft.

Dry Hole ✓

Abandoned ✓

Date

JAN 25 1933

192

CHAS. L. SHERWOOD

Scout