


Section 21 Township 28 Range 2-E

Well No. #1 Angel

Company Beech Aircraft
Miscellaneous

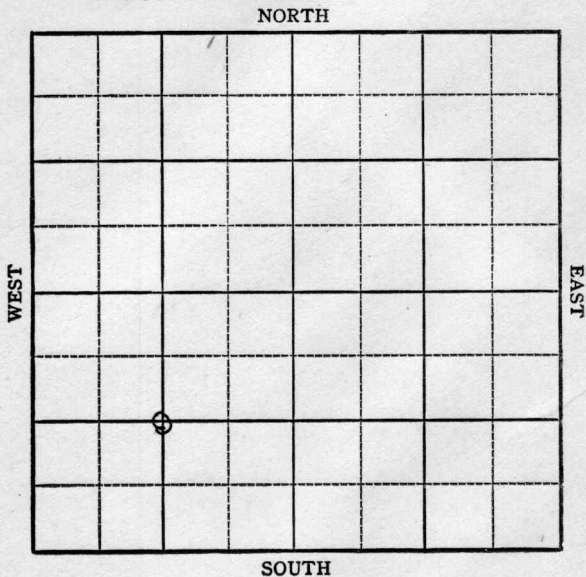

Sec. 21 Twp. 28 R. 2-E ✓

Well No. #1 Angel Farm


Beech Aircraft Company
Miscellaneous

1320 Ft. from N. Line

_____ Ft. from S. Line

1320 Ft. from E. Line

_____ Ft. from W. Line

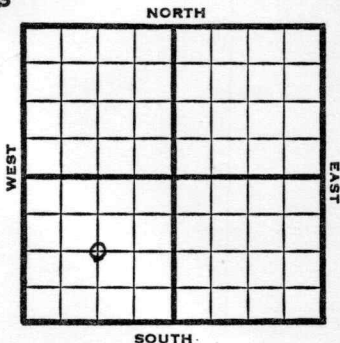

C SW

REPORT

1948	Eli 1333'
10/13	Drlg 1400'
10/19	15" @ 65' 12" @ 725' Sd 2270'
10/26	8" @ 2217' KC 2512' Drlg. 2540'
11/3	7" @ 2620' Drlg 2987'
11/10	TD 3080' Miss 2995' Aband

ABANDONED

Map No. _____ Sec. 21 Twp. 28 R. 2E

Well No. 1 Angel

Beech Aircraft Company

FIRST REPORT Contractor

C SW

SECTION PLAT

1320 Ft. from N. Line

_____ Ft. from S. Line

1320 Ft. from E. Line

_____ Ft. from W. Line

Sedgwick County

Location _____

Rig up _____

Drilling and Remarks:

drlg. 1400

RECORD

Cased _____ in., _____ ft.

Sand _____

Gas _____

Oil _____

Total Depth _____

PRODUCTION

1st 24 hrs. Nat. _____

1st 24 hrs. after shot _____

Gas _____ Cu. Ft.

Dry Hole _____

Abandoned _____

Date

OCT 13 1948 19

S. J. LEWIS Scout

Map No. 12 Sec. 21 Twp. 28 R. 2E

Well No. 1 Angel

Beech Aircraft

Company

ABANDONED

Contractor

C SW

E 11333

SECTION PLAT

1320 Ft. from N. Line

_____ Ft. from S. Line

1320 Ft. from E. Line

_____ Ft. from W. Line

Sedgwick County

Location _____

Rig up _____

Drilling and Remarks:

Miss 2995

RECORD

Cased _____ in., _____ ft.

Sand _____

Gas _____

Oil _____

Total Depth 3080

PRODUCTION

1st 24 hrs. Nat. _____

1st 24 hrs. after shot _____

Gas _____ Cu. Ft.

Dry Hole _____

Abandoned _____

Date

NOV 10 1948 19

S. J. LEWIS

Scout