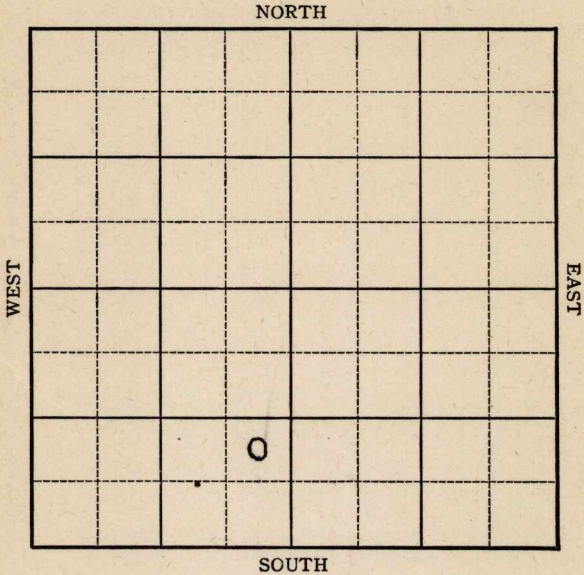


KANSAS

Greenwood

Section 14 Township 24 Range 12EWell No. 21 D.J. SullivanCompany Mid-Continent Petroleum Corp.

KANSAS

Greenwood

Sec. 14 Twp. 24-S R. 12-EWell No. #21 D. J. Sullivan FarmMid-Continent Petr. Corp. Company

Virgil

Ft. from N. Line


990

Ft. from S. Line

330

Ft. from E. Line

Ft. from W. Line

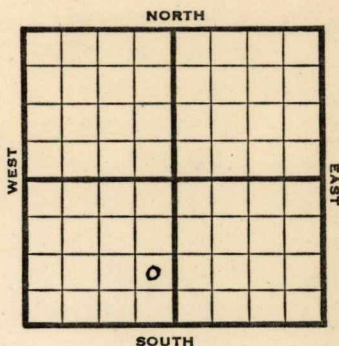

NE SE SW

1946

REPORT

3/26	Location notice only.	
5/8	Location by ticket	
5/11	Moving in rotary.	(Tol)
5/13	Moving in & RU	(P.R)
5/14	Spudded 5-13-46	
	9-5/8" set 13'2" with 8 sacks.	"
5/15	Drilling 540'	"
5/16	Drilling 910'	"
5/20	Top Lime 1761'	
	Coring 1768'	"
5/21	Coring 1785'	"
5/22	Top Miss. lime 1761'	
	No show in core	
	7" set 1764' w/50 sacks.	
	TD 1785'	"
5/23	Waiting on cement.	"
5/24	" "	"
5/27	" "	"
5/28	Waiting on Drilling in machine.	"
5/29	" "	"
5/31	Bailing mud.	"
6/3	Drilling out cement.	"
6/4	Testing -no oil.	"

OVER

1946

- 6/5 Bailed out to bottom.
Hole crooked; trying to drill.
T.D. 1785' (P.R)
- 6/6 Shut down to repair broken
clutch on motor. Smell of oil. "
- 6/7 $\frac{1}{2}$ gallon oil per hour
Running tubing to acidize tomorrow
T.D. 1792' "
- 6/10 Acidized with 2000 gals. 6-9
Rec. all but 10 bbls. load oil.
Will test. "
- 6/11 Pumped 16 hrs.
Rec. 50 bbls. water & 5 bbls. free
oil.
Testing "
- 6/12 Tested : 26 bbls. water & 6 bbls. Oil "
- 6/13 Completed 6-12-46
6 bbls. oil per day. T.D. 1792' "
- 6/19 Miss. 1761'
7" set 1764'
2000 acid
Total Depth 1785'
Pump 6 bbls. oil plug 26 water.
Potential.
Gravity 38.

COMPLETED

KANSAS

Kansas Pool Name VirgilMap No. 16 Sec. 14 Twp. 24 R. 12EWell No. #21 D. J. SullivanMid-Continent Petroleum Corp. Company

FIRST REPORT

Contractor

NE SE SW

SECTION PLAT

_____ Ft. from N. Line

990 Ft. from S. Line330 Ft. from E. Line

_____ Ft. from W. Line

Greenwood County

Location _____

Rig up _____

Drilling and Remarks:

RECORD

Cased _____ in., _____ ft.

Sand _____

Gas _____

Oil _____

Total Depth _____

PRODUCTION

1st 24 hrs. Nat. _____

1st 24 hrs. after shot _____

Gas _____ Cu. Ft.

Dry Hole _____

Abandoned _____

Date

MAY 8 1946

19

S. J. LEWIS

Scout

KANSASKansas Pool Name Virgil PoolMap No. 16 Sec. 14 Twp. 24 R. 12EWell No. 21 D. J. SullivanMid-Continent Petroleum Corp Company**COMPLETED**

Contractor

NE SE SW

SECTION PLAT

_____ Ft. from N. Line

990 Ft. from S. Line330 Ft. from E. Line

_____ Ft. from W. Line

Greenwood County

Location _____

Rig up _____

Drilling and Remarks:

Miss 1761
7" C 1764
2000 acid
Pump coil +
26W Rod

38 2/3

RECORD

Cased _____ in., _____ ft.

Sand _____

Gas _____

Oil _____

Total Depth 1785

PRODUCTION

1st 24 hrs. Nat. _____

1st 24 hrs. after shot _____

Gas _____ Cu. Ft.

Dry Hole _____

Abandoned _____

Date

JUN 19 1946

19

S. J. LEWIS

Scout