


Sedgwick

Form 51-5M-5-34-Palace

Map No. KANSAS Sec. 21 Twp. 28 R. 2 E

Well No. 1 Lauck Farm

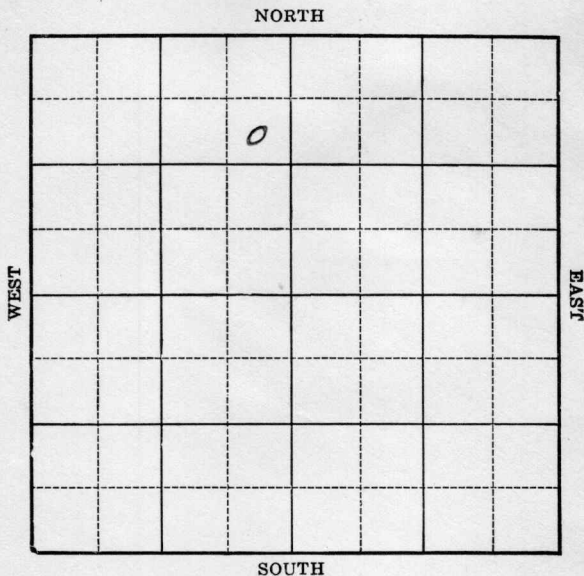

Location _____

Drilling Remarks _____

Rig Up _____

Drilling Remarks _____

RECORD

Cased _____ in. _____ ft.

Sand _____

Gas _____

Oil _____

Total Depth _____

PRODUCTION

1st 24 hrs. Nat. _____

1st 24 hrs. after shot _____

Gas _____ cu. ft.

Dry Hole _____

Abandoned _____

Sedgwick


Map No. Sec. 21 Twp. 28 R. 2E
Well No. 1 *Lauck* Farm
Aladdin Oil Company

990 Ft. from N. Line

 Ft. from S. Line

330 Ft. from E. Line

 Ft. from W. Line

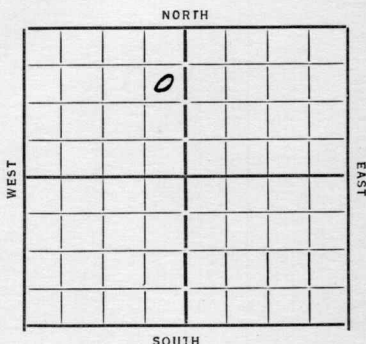

Date 1994

REPORT

10/10 B.R.
10/18 Rig
10/25 — 11/1 — 11/8 — 11/15 —
11/22 — 11/28 — 12/6 — 12/13 —
12/21 — 12/27 — 1/3/35 —
1/10 Rign
1/17 Dlg 720
1/24 " 1225
1/31 10" 1130
2/7 Dlg 2335
2/14 1 Gas 2440 KC 2502 8" 2667
2/21 Chrt 2966 TD 2968 Run 6"
2/28 6" 2968 HFW 3285
AML 3207 WX 3285
3/6 Wilcox 3285
Silicious 3355
TD 3370 7.5 A.

ABANDONED

Map No. 17 Sec. 21 Twp. 28 R. 2EWell No. 1-LauickAladdin Oil

Company

Contractor

FIRST REPORTS

SECTION PLAT

990 Ft. from N. Line

_____ Ft. from S. Line

330 Ft. from E. Line

_____ Ft. from W. Line

Location _____

Rig up _____

Drilling and Remarks:

B.R.

RECORD

Cased _____ in., _____ ft.

Sand _____

Gas _____

Oil _____

Total Depth _____

PRODUCTION

1st 24 hrs. Nat. _____

1st 24 hrs. after shot _____

Gas _____ Cu. Ft.

Dry Hole _____

Abandoned _____

Date

10-10-34

19

ORVAL MANNSCHRECK

Scout

Map No. 12 Sec. 21 Twp. 28 R. 2EWell No. 1-LaukAladdin pet Company

Contractor

ABANDONED

SECTION PLAT

	②		

990 Ft. from N. Line

Ft. from S. Line

330 Ft. from E. Line

Ft. from W. Line

Location

Rig up

Drilling and Remarks:

RECORD

Cased _____ in., _____ ft.

Sand Wilcox 3285Gas silurian 3355

Oil _____

Total Depth 3370

PRODUCTION

1st 24 hrs. Nat. _____

1st 24 hrs. after shot _____

Gas _____ Cu. Ft.

Dry Hole _____

Abandoned _____

Date

3-6-35 192 _____ Scout

ORVAL MANNSCHRECK