FORM 51


Sedgwick

KANSAS

Section 23 Township 28 Range 2E

Well No. #1 Moyniham

Company Cities Service Oil

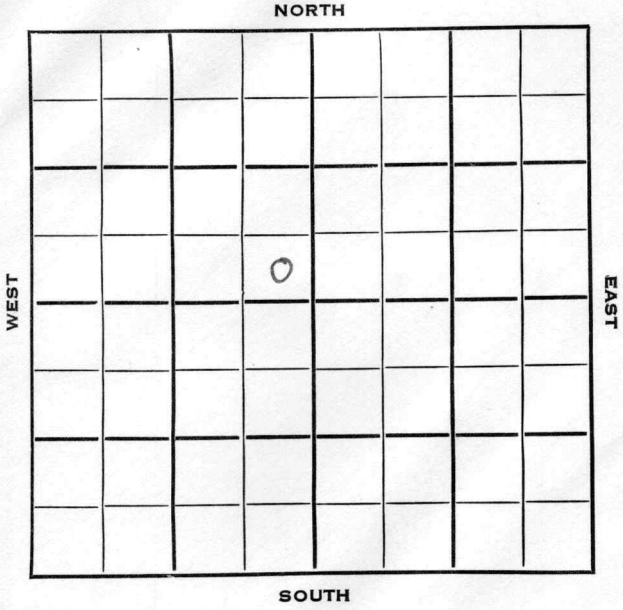

FORM 252-B

Sedgwick KANSAS ✓

Sec. 23 Twp. 28 R. 2 E

Well No. # 1 Moyniham Farm

Cities Service Oil Company

Brack Contractor

Wildcat


_____ Ft. from N. Line

330 Ft. from S. Line

330 Ft. from E. Line

_____ Ft. from W. Line

SE SE NW

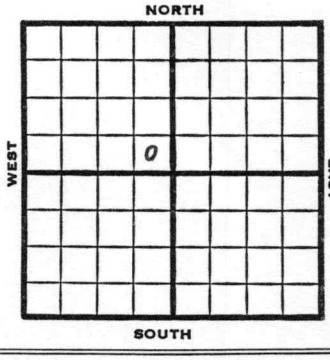

1953	REPORT
	Elev. 1363'
4/22	Spud 4-20-53 8" @ 125 Drlg. 215'
5/13	Spud 4-20-53 D & A TD 3361 8" @ 125 Top. 1517 Lans 2159 DST 2181-92 open 1 hr rec 4' mud 10# KC 2501 Miss. 2970 B. Miss 3207 Simp. 3273 DST 3272-88 open 1 hr rec 10' mud 1140# Arb. 3342' DST 3344-61 open 1 hr rec 2130' SW 1285# TD 3361 D & A ABANDONED

FORM 275 FOR SALE BY KANSAS BLUE PRINT CO.


County Sedgwick State Kansas

Sec. 23 (Blk. Twp.) 28 (Sur. Rge.) 2E Map No.

Operator Cities Service Oil

Well No. 1 Farm Moyniham

Elev. Location SE SE NW

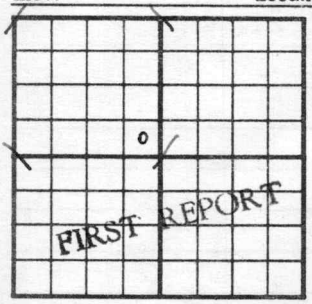

330 Ft. From S Line NW

330 Ft. From E Line Quarter

1st. Report APR 2 2 1953

Completion

Remarks

Brack - Contr.

Spudding Date 4-20-53

Drlg. Data Wildcat

8" @ 125 drlg. 215

J. G. McGEHEE

FORM 275 FOR SALE BY KANSAS BLUE PRINT CO.


County Sedgwick State Kansas

Sec. 23 (Blk. Twp.) 28 (Sur. Rge.) 2E Map No.

Operator Cities Service Oil

Well No. 1 Farm Moyniham

Elev. 1363 Location SE SE NW

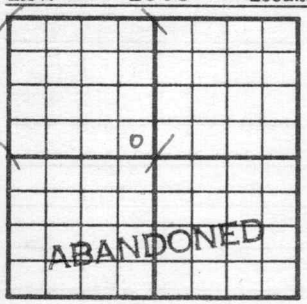

330 Ft. From S Line NW

330 Ft. From E Line Quarter

1st. Report

Completion MAY 1 3 1953

Remarks Wildcat

Brack - Contr.

Spudding Date 4-20-53

Drlg. Data D & A TD 3361

8" @ 125 Top. 1517 Lans. 2159

DST 2181-92 open 1 hr. Rec. 4' mud

10# KC 2501 Miss. 2970 B. Miss. 3207

Simp. 3273 DST 3272-88 open 1 hr.

Rec. 10' mud 1140# Arb. 3342

DST 3344-61 open 1 hr. Rec. 2130' sw

1285# TD 3361

D & A

J. G. McGEHEE