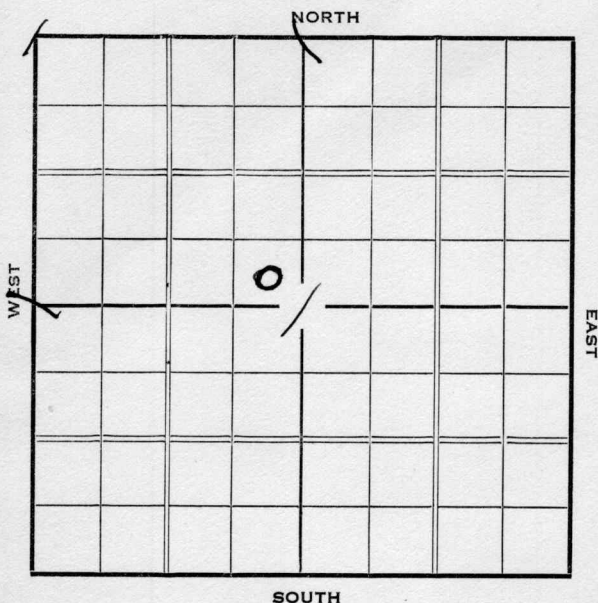



Sedgwick

KANSAS

Section 32 Township 28 Range 2EWell Number 1 Downs, Est.Company W. G. Talbott et al

Sec. 32 Twp. 28 R. 2-EWell No. #1 Downs, Est. FarmW.G. Talbott et al Company Ft. from N. Line330 Ft. from S. Line330 Ft. from E. Line Ft. from W. Line

Elev. 1320

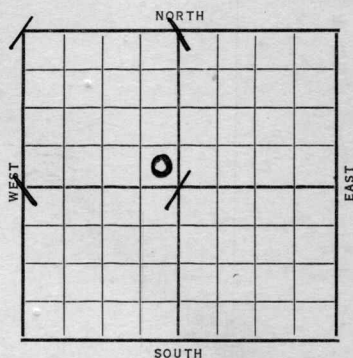

Date	REPORT
1937	
7/7	Location
7/16	R. U.
7/23	"
7/30	15" @ 83'. Drlg. 480'.
8/6	Drlg. 1000'.
8/13	12" @ 879'. Drlg. 1065'.
8/20	10" @ 1619'. Drlg. 1870'.
8/30	Top Stalnaker 2205
	At T.D. 2225 had 2,200,000 gas
	Gauged 13,396,000 gas at T.D. 2229
	May deepen (Tel)
9/3	Top Stalnaker 2215' (Corrected, @ 2225' 2,200,000 gas.
	T.D. 2232'. 13,896,000 gas.
	8" @ 2205'. WOC. No oil.
9/12	Drilled plug. Testing.
9/17	" " " "
9/24	39 M gas. 845# rock pressure.
10/2	7,342,000 gas.
10/8	" " "
10/15	" " "

OVER

1937

10/22 7,342,000 gas.

Shut in.

10/29 " "

11/3 5" @ 2205'.

Stalnaker 2215'.

T.D. 2232'.

7,400,000 gas.

COMPLETED

Sedgwick KANSAS

Map No. 12 Sec. 32 Twp. 28 R. 2 EWell No. 1 - Downs, E. st.N. G. Talbott et al Company

Contractor

FIRST REPORT

SECTION PLAT



_____ Ft. from N. Line

330 Ft. from S. Line330 Ft. from E. Line

_____ Ft. from W. Line

Location ✓

Rig up _____

Drilling and Remarks:

RECORD

Cased _____ in., _____ ft.

Sand _____

Gas _____

Oil _____

Total Depth _____

PRODUCTION

1st 24 hrs. Nat. _____

1st 24 hrs. after shot _____

Gas _____ Cu. Ft.

Dry Hole _____

Abandoned _____

Date

JUL 7 1937 19

H. D. Hatfield

Scout

Sedgwick KANSAS

Map No. 12 Sec. 32 Twp. 28 R2EWell No. 1 Downs Est.W. G. Talbott etal Company

Contractor

COMPLETED
SE NW

SECTION PLAT

	0		

 Ft. from N. Line330 Ft. from S. Line330 Ft. from E. Line Ft. from W. LineLocation Rig up

Drilling and Remarks:

7,400,000 gas

RECORD

Cased 5 in., 2205 ft.Sand Stalaker 2215Gas Oil Total Depth 2232

PRODUCTION

1st 24 hrs. Nat. 1st 24 hrs. after shot Gas Cu. Ft.Dry Hole Abandoned

Date

NOV 3 1937 19H. D. Hatfield Scout