

KANSAS


FORM 51 5M 11-44 PETROL

Greenwood County

Section 14 Township 24 Range 12E

Well No. #24 D. J. Sullivan

Company Mid-Cont. Petr. Corp.

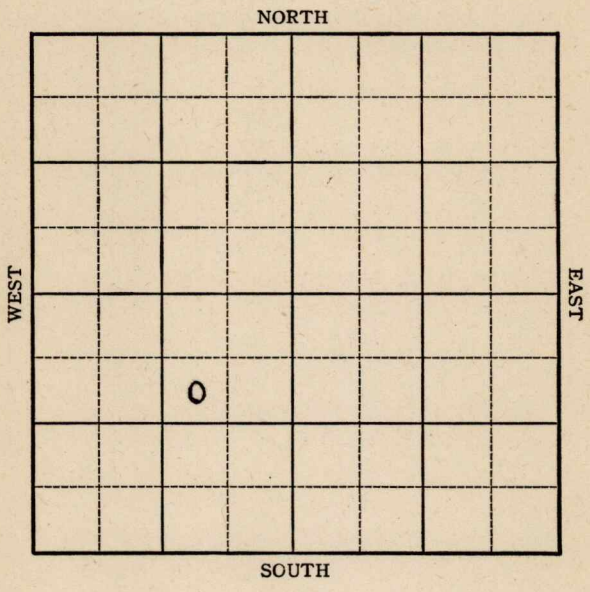


KANSAS

Greenwood ✓

Sec. 14 Twp. 24-S R. 12-EWell No. #24 D. J. Sullivan FarmMid-Continent Petr. Corp. Company990 Ft. from N. Line Ft. from S. Line990 Ft. from E. Line Ft. from W. Line

SW NE SW

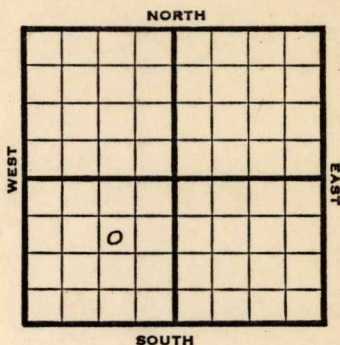

1946

REPORT

5/31	Location notice only.	
6/10	Spudding 6-10-46	(PR)
6/11	Set 10' 9-5/8" surface pipe w/9 sacks. T.D. 156' (Loc. by Ticket)	(PR)
6/12	Drilling 655'	"
6/13	Drilling 920'	"
6/14	Drilling 1150'	"
6/17	Top Arbuckle 1768' 7" set 1770' w/50 sacks. T.D. 1771'	"
6/18	Waiting on cement.	"
6/19	Waiting on drilling in machine.	"
6/20	" "	"
6/21	" "	"
6/24	" "	"
6/25	" "	"
6/26	" "	"
6/27	" "	"
6/28	" "	"
7/1	" "	"
7/2	" "	"
7/3	" "	"
7/5	Moving in drilling in machine.	"
7/8	Mud bailed out Ready to drill cement. T.D. 1771'	"

OVER

1946


7/9	Drilling 1782'	(P.R)
7/10	Fair show oil. T.D. 1794' Acidizing today with 2000 gal.	"
7/11	Pumpin g & testing.	"
7/12	Completed 7-12-46 10 bbls. per day!	"
7/17	Miss. 1768 7" @ 1770 2000 acid. TD 1794 Pump 10 Pot. Grav. 38.0	

COMPLETED

KANSASKansas Pool Name VirgilMap No. 14 Sec. 14 Twp. 24 R. 12EWell No. 24 D. J. SullivanMid-Continent Petroleum Corp. Company**FIRST REPORT**

Contractor

SW NE SW

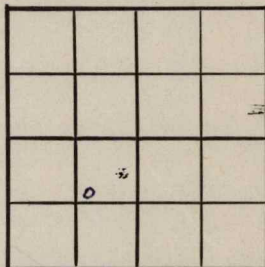SECTION PLAT990 Ft. from N. Line Ft. from S. Line990 Ft. from E. Line Ft. from W. LineGreenwood CountyLocation 6/10Rig up

Drilling and Remarks:

9 5/8 @ 10'230'**RECORD**Cased in., ft.Sand Gas Oil Total Depth **PRODUCTION**1st 24 hrs. Nat. 1st 24 hrs. after shot Gas Cu. Ft.Dry Hole Abandoned

Date

JUN 12 194619S. J. LEWISScout

KANSASKansas Pool Name Virgil PoolMap No. 16 Sec. 14 Twp. 24 R. 12EWell No. 24 D. J. SullivanMid-Continent Petrol. Corp. Company**COMPLETED**

Contractor

SW NE SW

SECTION PLAT

990 Ft. from N. Line

Ft. from S. Line

990 Ft. from E. Line

Ft. from W. Line

Greenwood County

Location

Rig up

Drilling and Remarks:

*Miss 1768**7" @ 1770**2000 acid**Pump 10 B.D.**980 ft***RECORD**

Cased _____ in., _____ ft.

Sand _____

Gas _____

Oil _____

Total Depth 1794**PRODUCTION**

1st 24 hrs. Nat. _____

1st 24 hrs. after shot _____

Gas _____ Cu. Ft.

Dry Hole _____

Abandoned _____

Date

JUL 17 1946 19S. J. LEWIS Scout