

Sedgwick

KANSAS

DX 78-1

Section 33 Township 28 Range 2E


Well No. #1 Goodin

Company J.P. Gaty

NORTH

WEST

EAST

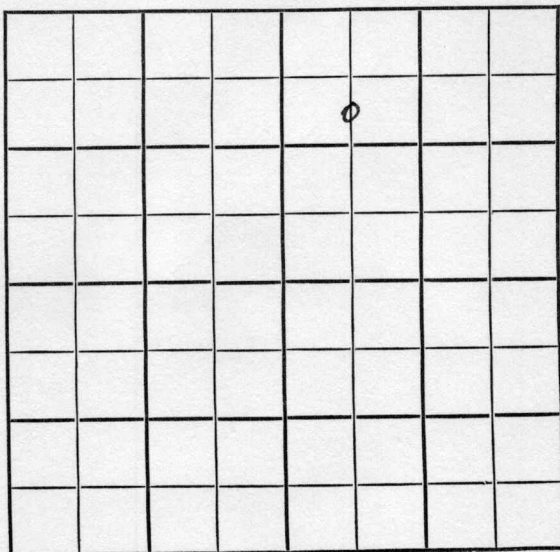

SOUTH

Sedgwick		KANSAS
SEC.	TWP.	R.
33	28	2E ✓

WELL NO.

#1 Goodin

FARM

COMPANY

J.P. Gaty

CONTRACTOR

Murfin Drlg.


990 Ft. from N. Line

Ft. from S. Line

Ft. from E. Line

660 Ft. from W. Line

C S $\frac{1}{2}$ NW NE

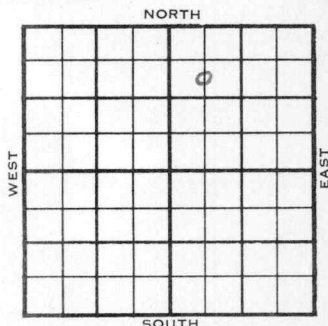

1954

ELEVATION

REPORT

5/19

Spud 5-10-54

Drlg 480'

6/2

Spudding 5-10-54

D & A

TD 2214

13" : 620 10" @ 1457


Br line 2184 Stal 2189 KC 2208

TD 2214

HFW

D & A

ABANDONED

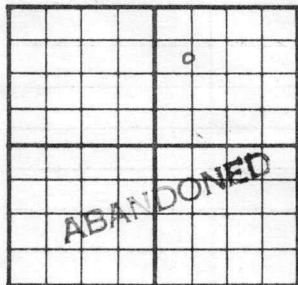County Sedgwick State KansasSec. 33 (Blk.
Twp.) 28 (Sur.
Rge.) 2E Map No. _____Operator J. P. GatyWell No. 1 Farm GoodinElev. 1304 Location C S $\frac{1}{2}$ NW NE990 Ft. From N Line NE660 Ft. From W Line Quarter

1st. Report _____

Completion JUN 2 1954

Remarks _____

Murfin Drlg. - Contr.Spudding Date 5-10-54Drlg. Data D & A TD 221413" @ 620 10" @ 1457 Br. lime 2184Stal. 2189 KC 2208 TD 2214 HFWD & A

J. G. McGEHEE