

Butler

KANSAS

Section 4 Township 28S Range # 3E

Well No. #2 Jerrick

Company G-M-R Oil

NORTH

0							

WEST

EAST

SOUTH

Sec. 4 Twp. 28 R. 3 E

Well No. # 2 Jerrick Farm

G-M-R Oil Company

Morrison Drlg. Contractor

1/4 Mile Creek Pool


 Ft. from N. Line

330 Ft. from S. Line

 Ft. from E. Line

330 Ft. from W. Line

SW SW NW

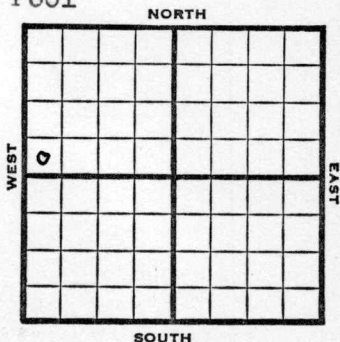

1952

Elev. 1314' REPORT

1/2

Set surface

1/16

D & A TD 3091' KC 2354'

B K C 2534' Miss 2848'

TD 3091' D & A

ABANDONED


County Butler State Kansas

Sec. 4 (Blk. Twp.) 28 (Sur. Rge.) 3 E Map No.

Operator G-M-R Oil

Well No. 2 Farm Jerrick

Elev. Location SW SW NW

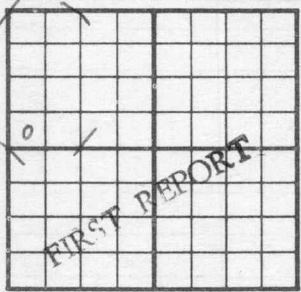

330 Ft. From S Line NW

330 Ft. From W Line Quarter

1st. Report JAN 2 1952

Completion

Remarks

Morrison Drlg. - Concr.

Spudding Date

Drlg. Data 4 Mile Creek Pool

Set surface

County Butler State Kansas

Sec. 4 (Blk. 28) (Sur. 3E) Map No.

Operator G-M-R Oil

Well No. 2 Farm Jerrick

Elev. 1314 Location SW SW NW

ABANDONED

330 Ft. From S Line NW

330 Ft. From W Line Quarter

1st. Report

Completion JAN 16 1952

Remarks 4 Mile Creek Pool
Morrison Drlg. - Contr.

Spudding Date

Drlg. Data D & A TD 3091

KC 2354 B KC 2534 Miss. 2848

TD 3091 D & A