

Section 5 Township 28 Range 3E

Well No. #3 Graham "A"

Company J. P. Gatty & Bill Graham

NORTH

						○			

SOUTH

WEST

EAST

Butler

KANSAS

Sec. 5 Twp. 28 R. 3 E

Well No. # 3 Graham "A" Farm

J.P. Gatty & Bill Graham Company

Morrison Drlg. Contractor

Four Mile Creek Pool


990 Ft. from N. Line

_____ Ft. from S. Line

990 Ft. from E. Line

_____ Ft. from W. Line

SW NE NE

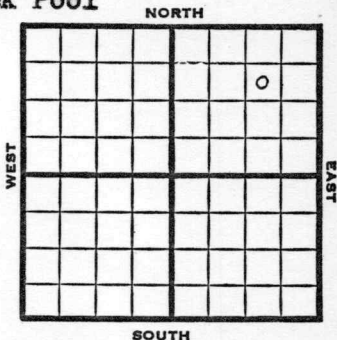

1951

Elev. 1299' REPORT

6/6 R U R

8/1 Oil Well TD 3040
 KC 2330 Simp 3039-40
 5" @ 3036 TD 3040
 150 bopd Hydrafrac
 Comp. 366 bopd 6% wtr.

COMPLETED

