

Section 3 Township 28 Range 3 EWell No. # 1 YoungCompany Mallonee Drlg.

NORTH

WEST

EAST

SOUTH

Sec. 3 Twp. 28 R. 3E

Well No. #1 Young Farm

Mallonee Drlg.

Company

Martin & Cash

Contractor

Wildcat

990

Ft. from N. Line


Ft. from S. Line

330

Ft. from E. Line

Ft. from W. Line

SE NE SE

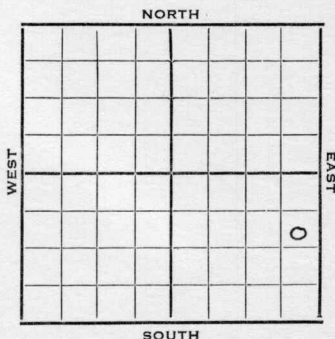

1952

Elev. 1291'

REPORT

6/4

M I R

6/25

Spud 6-5-52

D&A TD 3116

8" @ 171 Heeb. 1704

Lans. 1975 KC 2293

Miss 2779 Simp 3033

DST 3033-40 opn $\frac{1}{2}$ hr. Rec. 15' mud

Arb. 3091 TD 3116 D&A


ABANDONED

County **Butler** State **Kansas**
 Sec. **3** (Blk.) **28** (Sur.) **3E** Map No.

Operator **Mallonee Drlg.**

Well No. **1** Farm **Young**

Elev. Location **SE NE SE**

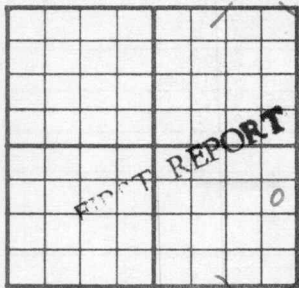

990 Ft. From **N** Line **SE**

330 Ft. From **E** Line Quarter

1st. Report **JUN 4 1952**

Completion

Remarks

Martin & Cash - Contr.

Spudding Date

Drlg. Data **Wildcat**

M I R

J. G. McGEHEE

County Butler State KansasSec. 3 (Blk.
Twp.) 28 (Sur.
Rge.) 3E Map No.Operator Mallonee Drlg.Well No. 1 Farm YoungElev. 1291 Location SE NE SE990 Ft. From N Line SE330 Ft. From E Line Quarter

1st. Report

Completion JUN 25 1952Remarks WildcatMartin & Cash - Contr.Spudding Date 6-5-52Drlg. Data D & A TD 31168" @ 171 Heeb. 1704 Lans. 1975KC 2293 Miss. 2779 Simp. 3033DST 3033-40 open $\frac{1}{2}$ hr. Rec. 15' mudArb. 3091 TD 3116D & A

J. G. McGENEE