


Butler

Section 5 Township 28 Range 3EWell No. #2 Graham "A"Company Gatty & Graham

NORTH

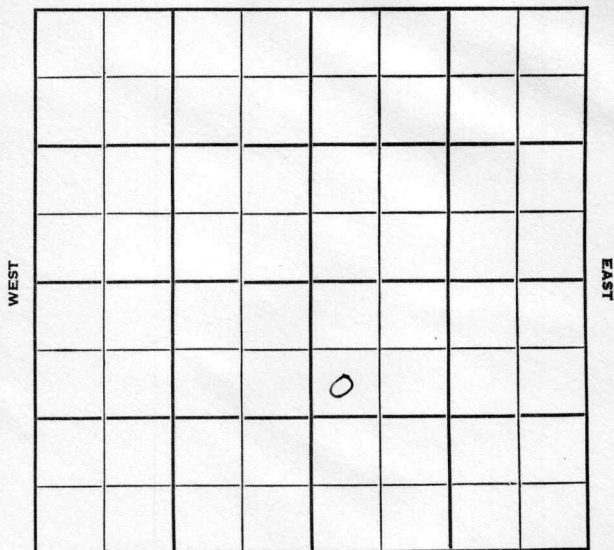

SOUTH

Butler KANSAS

Sec. 5 Twp. 28 R. 3E ✓

Well No. #2 Graham "A" Farm

Gatty & Graham Company

Contractor


990' Ft. from N. Line

Ft. from S. Line

Ft. from E. Line

330' Ft. from W. Line

SW NW SE

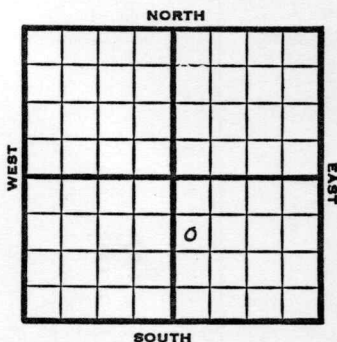

1951 Elev. 1317' REPORT

2/14 Location

5/2

Spud 4-8-51

D&A TD 3155

KC 2345 Simp 3064

Arb. 3145

7" @ 3061

TD 3155 D&A

ABANDONED

County Butler State KansasSec. 5 (Blk.
Twp.) 28 (Sur.
Rge.) 3E Map No. _____Operator Gatty & GrahamWell No. 2 Farm Graham "A"Elev. 1317 Location SW NW SE990 Ft. From N Line SE330 Ft. From W Line Quarter1st. ReportCompletion MAY 2 1951Remarks4 Mile creek PoolSpudding Date 4-8-51Drilg. Data D & A TD 3155KC 2345 Simp. 3064 Arb. 3145 7" @ 3061TD 3155 D & A

J. E. TYRA