

DX 78-1


Butler

KANSAS

Section 5 Township 28 Range 3E

Well No. #5 Graham "A"

Company Bill Graham

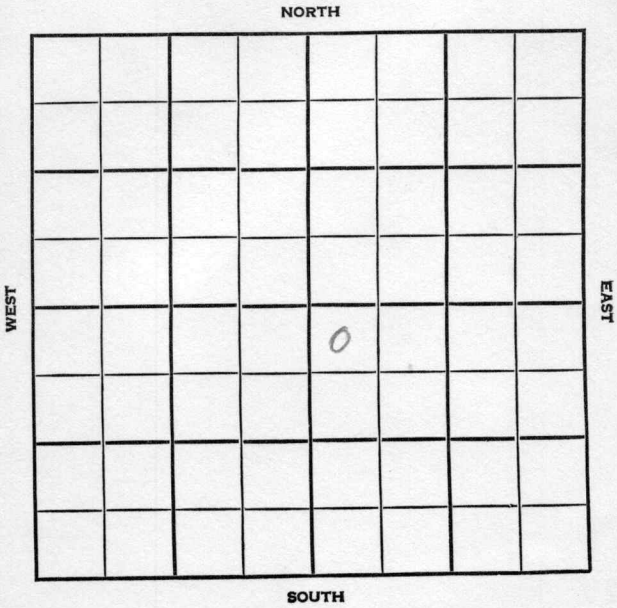

Butler

KANSAS

SEC.	TWP.	R.
5	28	3E

WELL NO. **5 Graham "A"** FARM

COMPANY **Bill Graham**

CONTRACTOR **Mallonee**

4 mile Creek Pool

330' _____ Ft. from N. Line

_____ Ft. from S. Line

_____ Ft. from E. Line

330' _____ Ft. from W. Line

NW NW SE

1955	ELEVATION 1313	REPORT
------	-------------------	--------

6/1 Spud 5-28-55
8" @ 59 w/35
Drlg 930

6/22 Comm 5-28-55
L 2020, KC 2359, M 2800, K 2998,
S 3060, TD 3062
8" @ 59/35 5 1/2" @ 3060/50
DD 3063 2 goph frac S/20 boph
5 bw Comp 25 bopd 20 bw

COMPLETED

County Butler Elev. 1313
 Sec. 5 Twp. 28 Rge. 3E
 Company Bill Graham
 Farm Name Graham "A" No. 5

Co.

TOPS	DEPTH	LOG	DATUM
Anh.			
T.P.			
H.			
Tr.			
Dg.			
B.L.			
L.	<u>2020</u>		<u>707</u>
K.C.	<u>2359</u>		<u>1046</u>
B.K.C.			
Ce.			
C.			
M.	<u>2800</u>		<u>1487</u>
M.			
K.	<u>2998</u>		<u>1685</u>
Mz.			
Mq.			
V.			
S.	<u>3060</u>		<u>1747</u>
S.			
A			
R.			
PE.			
G.			
T.D.	<u>3062</u>		

Loc. in Sec. NW NW SE
 Geol. _____
 Contr. _____
 Mallonee
 Pool
 4 mi. Creek

Lse.

COMPLETE

No.

Date Comm. 5-28-55 JUN 22 1955
8" @ 59/35 5 7/8" @ 3060/50 DD 3063

Sec.

2 goph frac S/ 20 boph 5 bw
Comp. 25 bopd 20 bw

T.

R.