


Section 5 Township 28 Range 3E

Well No. #1 Graham "B"

Company Gatty & Graham

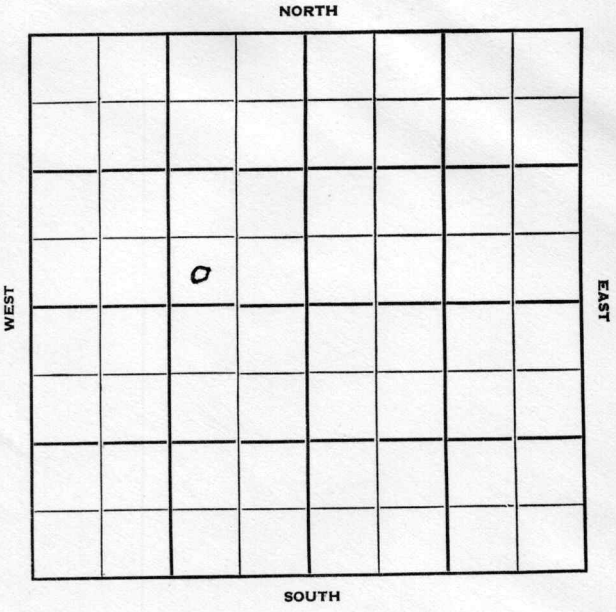

Sec. 5 Twp. 28 R. 3E

Well No. #1 Graham "B" Farm

Gatty & Graham Company

Morrison Drlg. - Contr. Contractor


_____ Ft. from N. Line

330' Ft. from S. Line

990' Ft. from E. Line

_____ Ft. from W. Line

SW SE NW

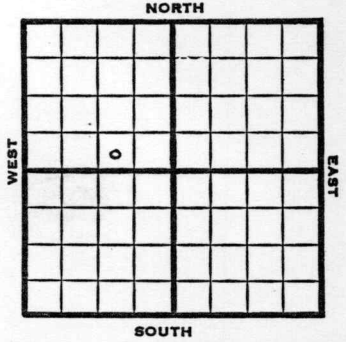

1951 Elev. 1308' REPORT

2/14 10" @ 105'

5/16 D&A TD 3156
 10" @ 105'
 Miss 2826 KC 2340
 Kinderhook 3014-70
 7" @ 3070
 Simp. 3075 Arb. 3151
 TD 3156
 D&A **ABANDONED**

