

KANSAS

Butler

Section 9 Township 28 Range 3E

Well No. 1 Delibuk

Company Ramsey Pet.

Wildcat
NORTH

WEST

EAST

				0			

SOUTH

KANSAS

Butler

Sec. 9 Twp. 28 R. 3E ☒

Well No. #1 Delibuk Farm

Ramsey Pet. Company

Wildcat

330'


Ft. from N. Line

Ft. from S. Line

Ft. from E. Line

330'

Ft. from W. Line

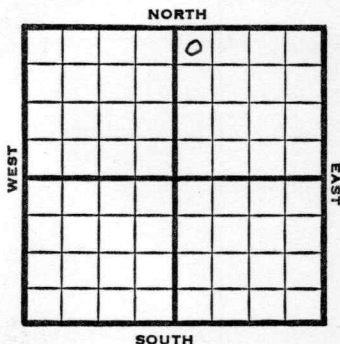

NW NE

1949

Elev 1325'

REPORT

4/13

8" @ 125'
Drlg. 500'

4/20

Simpson 3087'
TD 3091'
Run 5"

4/27

5" @ 3085'
TD 3095'

5/4

10 qts CO
TD 3152'
Simpson 3087'
Arb. 3148'
Aband.

ABANDONED

Map No. _____ Sec. 9 Twp. 28 R. 3E

Well No. 1 Delibuk

Ramsey Pet. Company

FIRST REPORT

Contractor

NW NE

SECTION PLAT

330 Ft. from N. Line

_____ Ft. from S. Line

_____ Ft. from E. Line

330 Ft. from W. Line

		2	

Butler County

Location _____

Rig up _____

Drilling and Remarks:

8" @ 125

dr1g. 500

RECORD

Cased _____ in., _____ ft.

Sand _____

Gas _____

Oil _____

Total Depth _____

PRODUCTION

1st 24 hrs. Nat. _____

1st 24 hrs. after shot _____

Gas _____ Cu. Ft.

Dry Hole _____

Abandoned _____

Date

APR 13 1949

19


S. J. LEWIS

Scout

Map No. K-12 Sec. 9 Twp. 28 R. 3EWell No. 1 DelibukRamsey Pet. Company**ABANDONED**

Contractor

NW NE

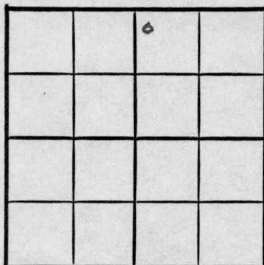E11825
SECTION PLAT330 Ft. from N. Line Ft. from S. Line Ft. from E. Line330 Ft. from W. LineButler County**RECORD**Location Rig up

Drilling and Remarks:

Shut down 3087Oct 31/48Cased in., ft.Sand Gas Oil Total Depth 8152**PRODUCTION**1st 24 hrs. Nat. 1st 24 hrs. after shot Gas Cu. Ft.Dry Hole Abandoned

Date

MAY 4 1949 19S. J. LEWIS

Scout