


LOCATION NOTICE

TULSA, OKLA., May 31, 1946

WELL NO. 24 ON D. J. Sullivan FARM

WILL BE AS FOLLOWS:

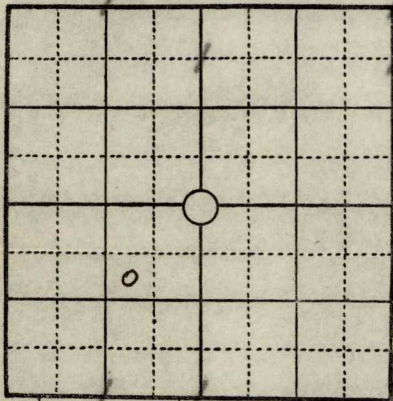

FEET FROM NORTH LINE
FEET FROM EAST LINE
1650 FEET FROM SOUTH LINE
330 FEET FROM WEST LINE
 $\frac{1}{2}$ $\frac{1}{2}$ & $\frac{1}{2}$ $\frac{1}{2}$ NE $\frac{1}{4}$
IN _____ SEC. 14 TWP. 24S RANGE 12E
Greenwood COUNTY, STATE OF KANSAS

REMARKS: Lloyd Snyder, District Supt.

J. G. Vorhees, Foreman

SIGNED ALP

COPIES TO

- DISTRICT SUPT.
- ACCOUNTING DEPT. 1
- RENTAL DEPT.
- SCOUTING DEPT.
- ENGINEERING DEPT.
- LEGAL DEPT.
- LEASE INVENTORY
- CLAIM DEPT.
- TAX DEPT.
- GEOLOGICAL DEPT.
- PURCHASING DEPT.
- PIPE LINE DEPT.
- PRIORITIES DEPT.
- FILE

Handwritten signature/initials

Handwritten signature/initials

Handwritten signature/initials