

KANSAS

Section 5 Township 28 Range 3-EWell No. #1 RobinsonCompany J P Gatty

NORTH

						0	

WEST

EAST

SOUTH

Butler KANSAS

Sec. 5 Twp. 28 R. 3E

Well No. #1 Robinson Graham Farm

J. P. Gatty Company

Morrison Drlg. - Contr. Contractor

Wildcat


 Ft. from N. Line

330' Ft. from S. Line

990' Ft. from E. Line

 Ft. from W. Line

SW SE NE

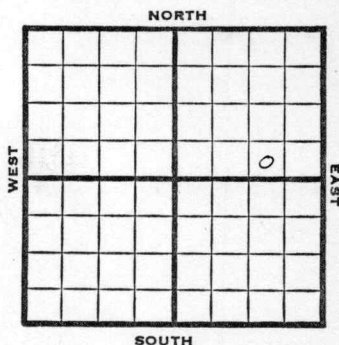

1950

Elev 1318'

REPORT

12/27

Spud 12-21-50
Drlg. 1700'

1951

1/24

Lans 2002

Miss 2804

Simp 3070

5" @ 3064

TD 3072

F/4 boph

Comp 2068 bopd

Completed

Kc 23400

Kinderhook 3012

COMPLETED


County Butler State KansasSec. 5 (Blk. 28 (Sur. 3E (Twp.) (Rge.) Map No.Operator J. P. GattyWell No. 1 Farm RobinsonElev. Location SW SE NE330 Ft. From S Line NE990 Ft. From E Line Quarter1st. Report DEC 27 1950

Completion

Remarks

Morrison Drlg. - Contr.Spudding Date 12-21-50Drlg. Data Wildcatdrlg. 1700

J. E. TYRA

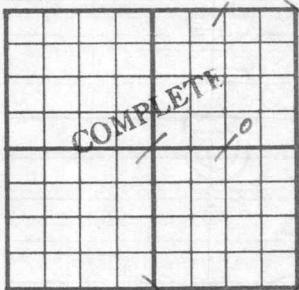County Butler State KansasSec. 5 (^{Blk.}_{Twp.}) 28 (^{Sur.}_{Rge.}) 3E Map No.Operator J. P. GattyWell No. 1 Farm Robinson GrahamElev. 1318 Location SW SE NE330 Ft. From S Line NE990 Ft. From E Line Quarter

1st. Report

Completion JAN 24 1951Remarks WildcatMorrison Drlg. - Contr.Spudding Date 12-21-50Drlg. Data Oil well TD 3072Lans. 2002 KC 2340 Miss. 2804Kinderhook 3012 Simp. 3070 5" @ 3064TD 3072 F/ 4 boph Comp. 2068 bopd

J. E. TYRA