
FORM 51 25M 8-50 WESTERN Butler KANSAS

Section 8 Township 28 Range 3E

Well No. #1 Stoner

Company J. P. Gatty et al

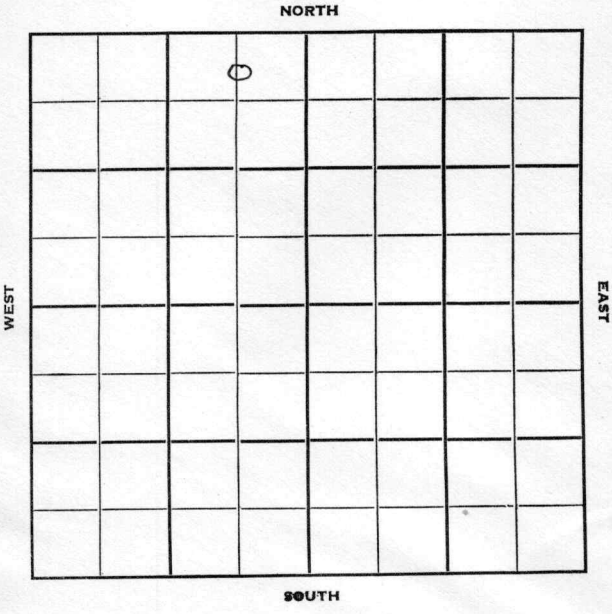

FORM 252-B
10M 10-50 PETROL

Butler

KANSAS

Sec. 8 Twp. 28 R. 3E

Well No. #1 Stoner Farm

J. P. Catty et al Company

Morrison Drlg. Contractor

Semi-Wildcat.


330 Ft. from N. Line

Ft. from S. Line

660 Ft. from E. Line

Ft. from W. Line

C N L NE NW

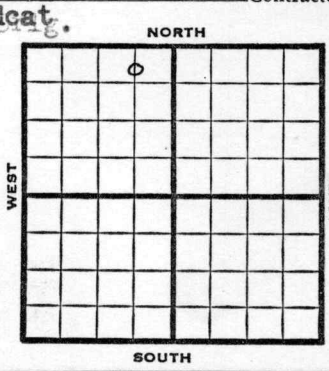

1951	Elev. 1318' REPORT
12/5	Set surface
1952 1/2	Spud 12-5-51 D & A TD 3091' 8" @ 90' KC 2357' Miss 2850' 5" @ 3084' Simp. 3088-91' TD D & A

ABANDONED

FORM 275 FOR SALE BY KANSAS BLUE PRINT CO.


County Butler State Kansas

Sec. 8 (Blk. Twp.) 28 (Sur. Rge.) 3E Map No.

Operator J. P. Gatty etal.

Well No. 1 Farm Stoner

Elev. Location C N L NE NW

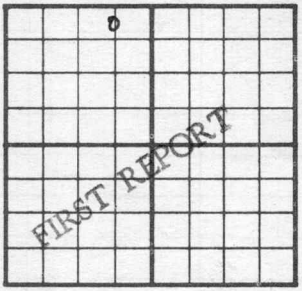

330 Ft. From N Line NW

660 Ft. From E Line Quarter

1st. Report DEC 5 1951

Completion

Remarks

Morrison Drlg. - Contr.

Spudding Date

Drlg. Data Semi Wildcat

Set surface

J. E. TYRA

FORM 275 FOR SALE BY KANSAS BLUE PRINT CO.


County Butler State Kansas

Sec. 8 (Blk. / Twp.) 28 (Sur. / Rge.) 3E Map No.

Operator J. P. Gatty etal.

Well No. 1 Farm Stoner

Elev. 1318 Location C N L NE NW

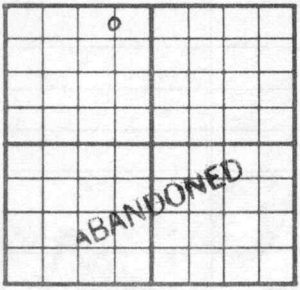

330 Ft. From N Line NW

660 Ft. From E Line Quarter

1st. Report

Completion JAN 2 1952

Remarks Semi Wildcat

Morrison Drlg. - Contr.

Spudding Date 12-5-51

Drlg. Data D & A TD 3091

8" @ 90 KC 2357 Miss. 2850 5" @ 3084

Simp. 3088-91 TD

D & A

J. E. TYRA