


LOCATION NOTICE

TULSA, OKLA., March 26, 1946, 19.....

WELL NO. 21 ON D. J. Sullivan FARM

WILL BE AS FOLLOWS:

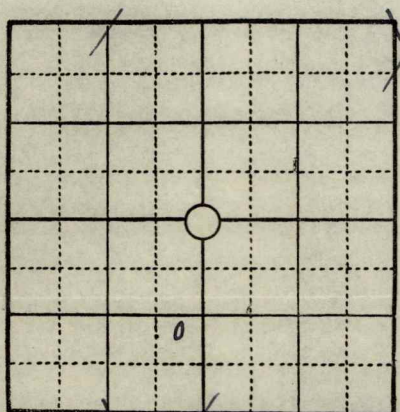

..... FEET FROM NORTH LINE
330
 FEET FROM EAST LINE
990
 FEET FROM SOUTH LINE
 FEET FROM WEST LINE
E $\frac{1}{2}$ W $\frac{1}{2}$ & N $\frac{1}{2}$ N $\frac{1}{2}$ NE $\frac{1}{4}$
 IN SEC. 14 TWP. 24S RANGE 12E
Greenwood COUNTY, STATE OF Kansas

REMARKS: Lloyd Snyder, Dist. Supt.
J. G. Vorhees, Foreman.

A. E. PIERCE

SIGNED.....

COPIES TO

- DISTRICT SUPT.
- ACCOUNTING DEPT.
- RENTAL DEPT.
- SCOUTING DEPT.
- ENGINEERING DEPT.
- LEGAL DEPT.
- LEASE INVENTORY
- CLAIM DEPT.
- TAX DEPT.
- GEOLOGICAL DEPT.
- PURCHASING DEPT.
- PIPE LINE DEPT.
- PRIORITIES DEPT.
- FILE

*32-50
3N-
also
Recy*

36161

*was not
seen*

N6 N6 SW

*condor
Miss. Longell Maps.*