


LOCATION NOTICE

TULSA, OKLA., May 31, 1946

WELL NO. 23 ON D. J. Sullivan FARM

WILL BE AS FOLLOWS:

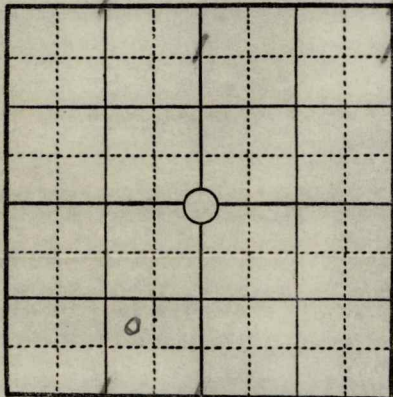

..... FEET FROM NORTH LINE

..... FEET FROM EAST LINE

990 FEET FROM SOUTH LINE

330 FEET FROM WEST LINE

E 1/2 W 1/2 & N 1/2 W 1/2 NE 1/4

IN SEC. 14 TWP. 24S RANGE 12E

Greenwood COUNTY, STATE OF Kansas

REMARKS: Lloyd Snyder, District Supt.

J. C. Vorhees

.....

.....

SIGNED *Albina*

COPIES TO

- DISTRICT SUPT.
- ACCOUNTING DEPT.
- RENTAL DEPT.
- SCOUTING DEPT.
- ENGINEERING DEPT.
- LEGAL DEPT.
- LEASE INVENTORY
- CLAIM DEPT.
- TAX DEPT.
- GEOLOGICAL DEPT.
- PURCHASING DEPT.
- PIPE LINE DEPT.
- PRIORITIES DEPT.
- FILE

ewc jpp

and 32

Smith