


## LOCATION NOTICE

TULSA, OKLA., June 10, 1948WELL NO. 31 ON George Wayham FARM

WILL BE AS FOLLOWS:

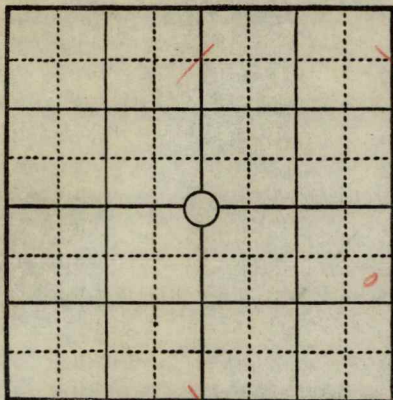

..... FEET FROM NORTH LINE

330

..... FEET FROM EAST LINE

1650

..... FEET FROM SOUTH LINE

..... FEET FROM WEST LINE

SE/4 & S/2 NE/4 & S/2 N/2 NE/4IN..... SEC. 14 TWP. 24S RANGE 12EGreenwood COUNTY, STATE OF KansasREMARKS: Lloyd Snyder - Dist. SuperintendentJ. G. Vorhees - Foreman

.....

.....

SIGNED..... A. E. Pierce

COPIES TO

MR. KOONTZ McDowell

DISTRICT SUPT.

ACCOUNTING DEPT.

✓ SCOUTING DEPT.

GEOLOGICAL DEPT.

PIPE LINE DEPT.

MATERIALS DEPT.

RENTAL DEPT.

LEGAL DEPT.

TAX DEPT.

ENGINEERING DEPT.

LEASE INVENTORY

CLAIM DEPT.

FILE

w  
Card  
J. G. M.

mapped  
core