


LOCATION NOTICE

TULSA, OKLA., June 20, 1949

WELL NO. 33 ON George Wayham FARM

WILL BE AS FOLLOWS:

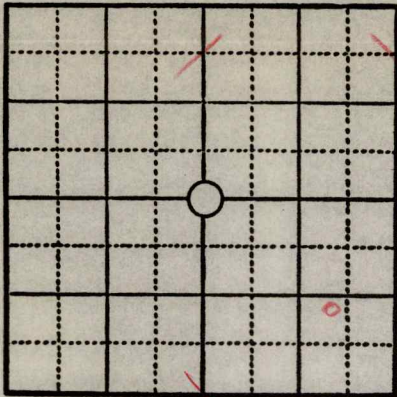

FEET FROM NORTH LINE

750

FEET FROM EAST LINE

1060

FEET FROM SOUTH LINE

FEET FROM WEST LINE

SE/4 & S/2 NE/4 & S/2 N/2 NE/4

IN SEC. 14 TWP. 24S RANGE 12E

Greenwood COUNTY, STATE OF Kansas

REMARKS: S. K. McLanahan — Dist. Supt.

J. G. Vorhees — Foreman

M. C. P. C. — 100%

SIGNED

A. E. Pierce

COPIES TO

MR. McDOWELL
 DISTRICT SUPT.
 ACCOUNTING DEPT.
 SCOUTING DEPT.
 GEOLOGICAL DEPT.
 PIPE LINE DEPT.
 MATERIALS DEPT.
 RENTAL DEPT.
 LEGAL DEPT.
 MR. LEO MEYER
 ENGINEERING DEPT.
 LEASE INVENTORY
 CLAIM DEPT.
 MR. J. W. BASORE
 FILE

conf
Jgm
Meyers
Ed