


LOCATION NOTICE

TULSA, OKLA., March 26, 1946

WELL NO. 25 ON George Wayham FARM

WILL BE AS FOLLOWS:

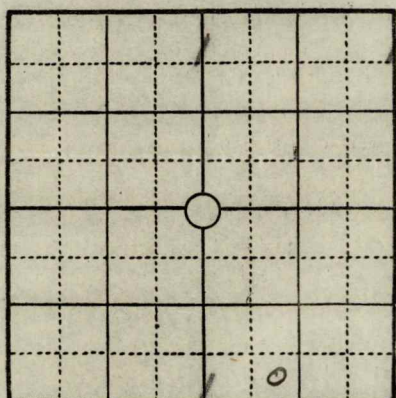

FEET FROM NORTH LINE

FEET FROM EAST LINE

330

FEET FROM SOUTH LINE

990

FEET FROM WEST LINE

SE 1/4 & S 1/2 NE 1/4 & S 1/2 N 1/2 NE 1/4

IN SEC. 14 TWP. 24S RANGE 12E

Greenwood COUNTY, STATE OF Kansas

REMARKS: Lloyd Snyder, Dist. Supt.

J. G. Vorhees, Foreman.

SIGNED [Signature]

COPIES TO

DISTRICT SUPT.
ACCOUNTING DEPT.
RENTAL DEPT.
SCOUTING DEPT.
ENGINEERING DEPT.
LEGAL DEPT.
LEASE INVENTORY
CLAIM DEPT.
TAX DEPT.
GEOLOGICAL DEPT.
PURCHASING DEPT.
PIPE LINE DEPT.
PRIORITIES DEPT.
FILE

Well map
card
Small map