

KANSAS


Butler

FORM 51 IOM 12-46 PETROL

Section 26 Township 28 Range 3E

Well No. 5 Hawks

Company Padeco etal

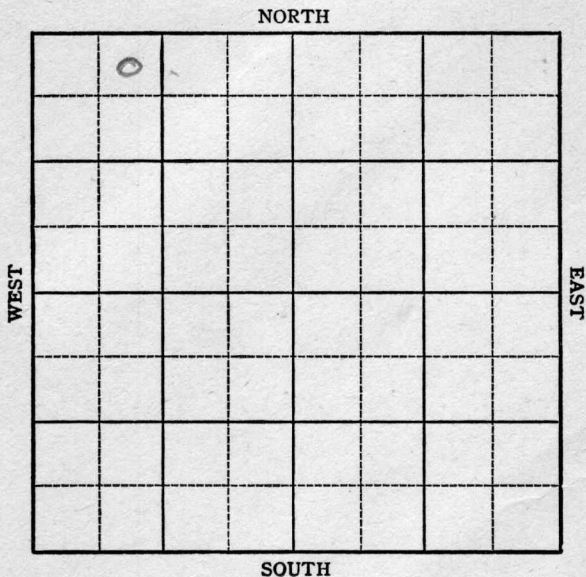

KANSAS

Butler County

26

28

3E

Sec. _____ Twp. _____ R. _____

Well No. 5 Hawks Farm _____

Padeco et al

Company _____

Miscellaneous

330


_____ Ft. from N. Line

_____ Ft. from S. Line

_____ Ft. from E. Line

990

_____ Ft. from W. Line

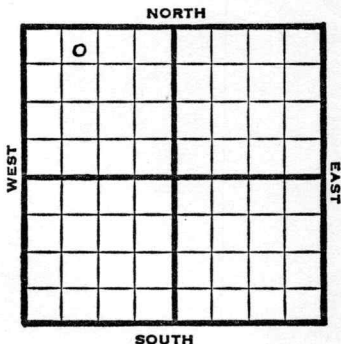

NE NW NW

1947

Elev. 1325' REPORT

5/28 Location

6/3 Spud

6/10 Miss. 2767'
TD 2975'
5" @ 2975'
RUST.

6/17 Simp. 2988'
TD 2995'
150' oil

6/24 " "

7/2 Simp. 2988'
5" @ 2975'
Pump 65 Pot
38.0 Gr.
TD. 2995'

COMPLETED

Map No. _____ Sec. 26 Twp. 28 R. 3E

Well No. 5 Hawks

Padeco etal. Company

FIRST REPORT Contractor

NE NW NW

SECTION PLAT

330 Ft. from N. Line

_____ Ft. from S. Line

_____ Ft. from E. Line

990 Ft. from W. Line

0			

Butler County

Location X

Rig up _____

Drilling and Remarks: _____

RECORD

Cased _____ in., _____ ft.

Sand _____

Gas _____

Oil _____

Total Depth _____

PRODUCTION

1st 24 hrs. Nat. _____

1st 24 hrs. after shot _____

Gas _____ Cu. Ft.

Dry Hole _____

Abandoned _____

Date

MAY 28 1947

19

S. J. LEWIS

Scout

Map No. 12 Sec. 26 Twp. 28 R. 3EWell No. 5 HawksPadeco etal. CompanyCOMPLETE Contractor

NE NW NW

E 11825

SECTION PLAT

8			

330 Ft. from N. Line Ft. from S. Line Ft. from E. Line990 Ft. from W. LineButler CountyLocation Rig up

Drilling and Remarks:

Dring 2988
5102975Pump 650008-1/2

RECORD

Cased in., ft.Sand Gas Oil Total Depth 2985

PRODUCTION

1st 24 hrs. Nat. 1st 24 hrs. after shot Gas Cu. Ft.Dry Hole Abandoned

Date

JUL 2 1947 19S. J. LEWIS Scout