

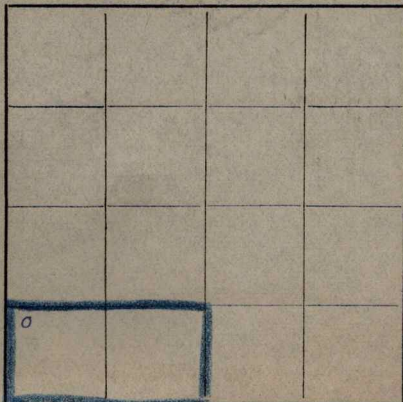
10-27-14
Kaw

LOCATION NOTICE

Tulsa, Okla., October 16, 1917 No. 140To LEONARD LOOP,Address AUGUSTA, KANS.COSDEN OIL & GAS COMPANY

will drill a well

as described below, and this notice will be your authority for commencement of work.

The location will be on H. C. BATES Farmin S/2 of the SW/4 of Section 10 Township 27-S Range 4-EBUTLERCounty, State of KANSASWell No. 6250 feet from North line

feet from East line

feet from South line

230 feet from West lineRemarks: Rig skidded 30'East of original location, a/o first hole being lost.

Copies to

Accounting Dept.
 Engineering Dept.
 Legal Dept.
 Rental Dept.
 Scouting Dept.

(Signed)