

KANSAS

FORM 51 IOM 12-46 PETROL

Butler

Section 27 Township 28 Range 3E

Well No. 2 Hawks Est.

Company Padco et al

Misc.		NORTH					
WEST							0
SOUTH							

Sec. 27 Twp. 28 R. 3E

Well No. 2 Hawks Est. Farm

Padco et al Company

Butler County

330 Ft. from N. Line


 Ft. from S. Line

330 Ft. from E. Line

 Ft. from W. Line

NE/C

Elev. Est. 1314'

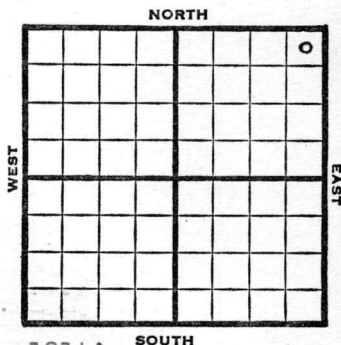

1947

REPORT

3/26 Location.

4/2 Drlg. 1435'

4/9
Simp. 2982
5" @ 2973'
Pump 45 Pot
Grav. 38
TD 2987'

COMPLETED

Map No. K12 Sec. 27 Twp. 28 R. 3EWell No. 2 Hawks Est.Padco etal. CompanyFIRST REPORT Contractor

NE/C

SECTION PLAT

			o

330 Ft. from N. Line Ft. from S. Line330 Ft. from E. Line Ft. from W. LineButler CountyLocation XRig up

Drilling and Remarks:

RECORD

Cased in., ft.Sand Gas Oil Total Depth

PRODUCTION

1st 24 hrs. Nat. 1st 24 hrs. after shot Gas Cu. Ft.Dry Hole Abandoned

Date

MAR 26 194719S. J. LEWISScout

Map No. A12 Sec. 27 Twp. 28 R. 3E

Well No. 2 Hawks Est.

Padco etal. Company

COMPLETE Contractor

NE/C


E. 13/4
SECTION PLAT

330 Ft. from N. Line

 Ft. from S. Line

330 Ft. from E. Line

 Ft. from W. Line

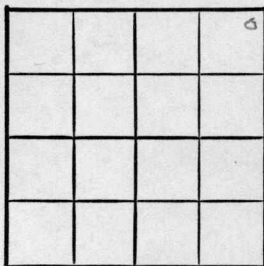

Butler County

Location

Rig up

Drilling and Remarks:

*Drill 2982
5102973*

Pump 45 ft

35 1/2

RECORD

Cased in., ft.

Sand

Gas

Oil

Total Depth 2987

PRODUCTION

1st 24 hrs. Nat.

1st 24 hrs. after shot

Gas Cu. Ft.

Dry Hole

Abandoned

Date

APR 9 1947 19

S. J. LEWIS Scout