


Map No. _____ Sec. 10 Twp. 27 R. 4Well No. 6 Bates Farm _____
Cosden Company

NORTH

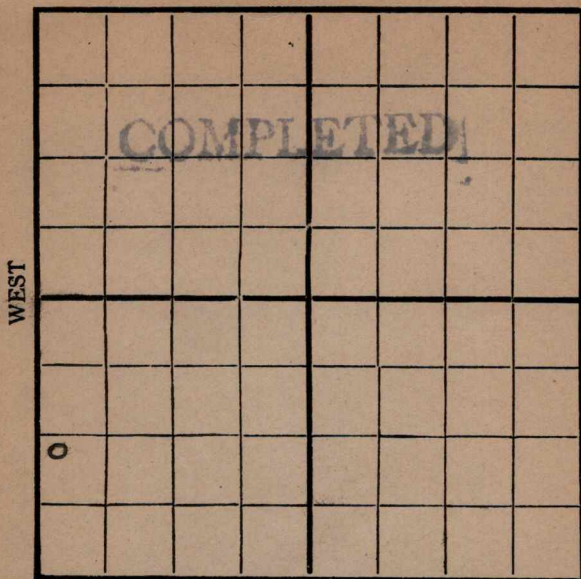

SOUTH

Location _____

Rig Up _____

Drilling Remarks:

Drilling Remarks:

RECORD

Cased _____ in _____ Ft.

Sand _____

Gas _____

Oil _____

Total Depth _____

PRODUCTION

1st 24 hrs. Nat. _____

1st 24 hrs. after shot _____

Gas _____ Cu. Ft.

Dry Hole _____


Abandoned _____

Map No. _____ Sec. 10 Twp. 27 R. 4
 Well No. 6 Bate Farm _____
Cosden Company _____

NORTH

WEST

EAST

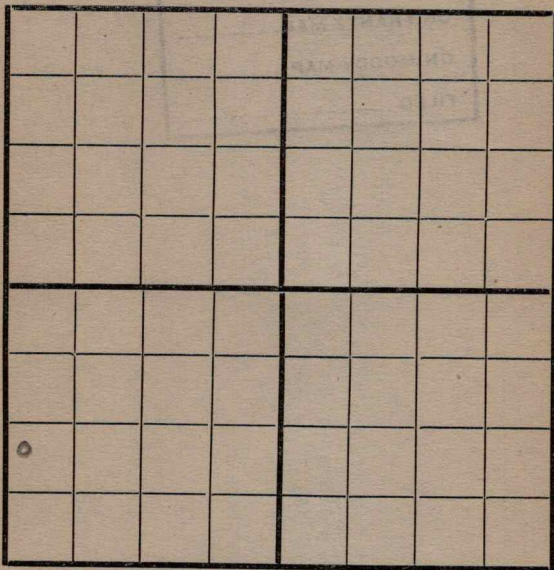

SOUTH

Location ✓

Rig Up _____

Drilling and remarks

250' S of N Line
200' E of W Line

First Report

RECORD

Cased _____ in. _____ Ft.

Sand _____

Gas _____

Oil _____

Total Depth _____

PRODUCTION

1st 24 hrs. Nat. _____

1st 24 hrs. after shot _____

Gas _____ Cu. Ft.

Dry Hole _____

Abandoned _____

Date


5/2, 1917 Cosden Scout

Map No. _____ Sec. 10 Twp. 27 R. 4
 Well No. 6 Bates Farm _____
Co. Don Company _____

NORTH

WEST

EAST

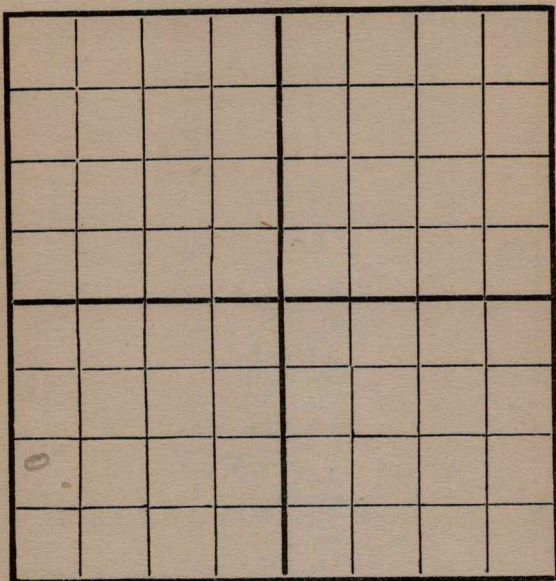

SOUTH

Location _____
 Rig Up _____
 Drilling and remarks

210

RECORD

Cased _____ in. _____ Ft.
 Sand _____
 Gas _____
 Oil _____
 Total Depth _____

PRODUCTION

1st 24 hrs. Nat. _____
 1st 24 hrs. after shot _____
 Gas _____ Cu. Ft.
 Dry Hole _____
 Abandoned _____

Date

3/24/27 191 Co. Don Scout

Map No. _____ Sec. 10 Twp. 27 R. 4
 Well No. 6 Bates _____ Farm _____
Cash _____ Company _____

NORTH

WEST

EAST

SOUTH

Location _____

Rig Up _____

Drilling and remarks

700

RECORD

Cased _____ in. _____ Ft.

Sand _____

Gas _____

Oil _____

Total Depth _____

PRODUCTION

1st 24 hrs. Nat. _____

1st 24 hrs. after shot _____

Gas _____ Cu. Ft.

Dry Hole _____


Abandoned _____

Date

6/1, 1917 Cash Scout

Map No. _____ Sec. 10 Twp. 27 R. 4
Well No. 6372 _____ Farm _____
_____ Company _____

NORTH

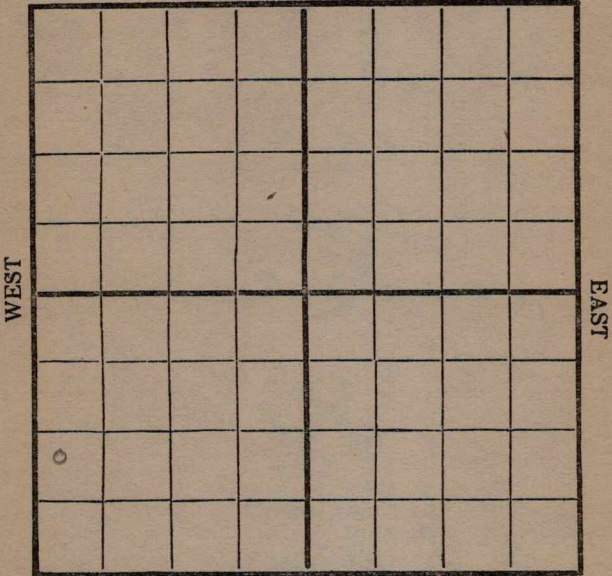

SOUTH


Location _____ Rig Up _____ Drilling and remarks <u>1400</u>	RECORD
	Cased _____ in. _____ Ft.
	Sand _____
	Gas _____
	Oil _____
	Total Depth _____
	PRODUCTION
	1st 24 hrs. Nat. _____
	1st 24 hrs. after shot _____
	Gas _____ Cu. Ft.
	Dry Hole _____
	Abandoned _____

Date 6/9, 1917, Canada Scout

Map No. _____ Sec. 10 Twp. 27 R. 4Well No. 61 Bates Farm _____
Candler Company

NORTH

WEST

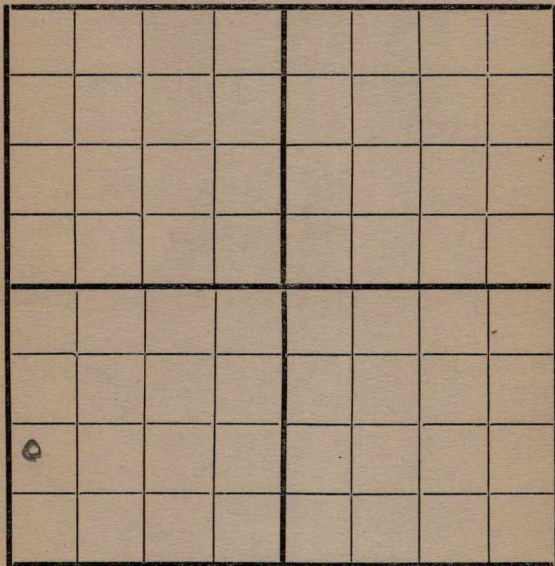

EAST

SOUTH

Location _____

Rig Up _____

Drilling and remarks

1708

RECORD

Cased _____ in. _____ Ft.

Sand _____

Gas _____

Oil _____

Total Depth _____

PRODUCTION

1st 24 hrs. Nat. _____

1st 24 hrs. after shot _____

Gas _____ Cu. Ft.

Dry Hole _____

Abandoned _____


Date

6/15, 1917 Candler Scout

Map No. _____ Sec. 10 Twp. 27 R. 4Well No. 61305 _____ Farm _____

_____ Company _____

NORTH

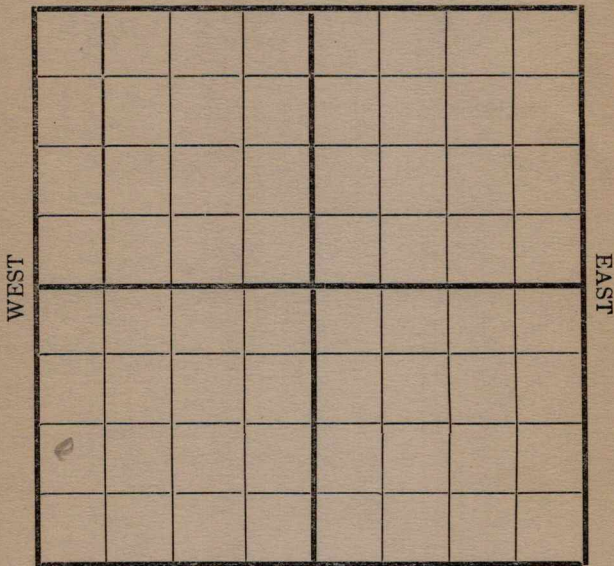

SOUTH

Location _____

Rig Up _____

Drilling and remarks

2000'

RECORD

Cased _____ in. _____ Ft.

Sand _____

Gas _____

Oil _____

Total Depth _____

PRODUCTION

1st 24 hrs. Nat. _____

1st 24 hrs. after shot _____

Gas _____ Cu. Ft.

Dry Hole _____

Abandoned _____

Date


6/22, 1917 Carley Scout

Map No. _____ Sec. 10 Twp. 27 R. 4
 Well No. 6130 Farm _____
Co. 100 Company _____

NORTH

WEST

EAST

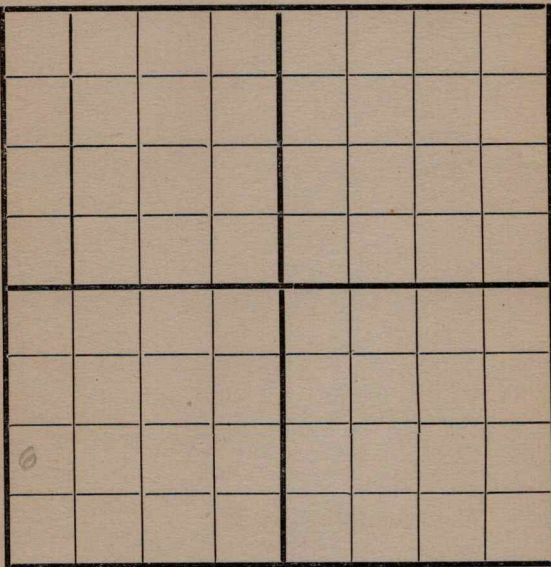

SOUTH

Location _____
 Rig Up _____
 Drilling and remarks _____

2140

RECORD

Cased _____ in. _____ Ft.
 Sand _____
 Gas _____
 Oil _____
 Total Depth _____

PRODUCTION

1st 24 hrs. Nat. _____
 1st 24 hrs. after shot _____
 Gas _____ Cu. Ft.
 Dry Hole _____
 Abandoned _____

Date


6/29, 1912 Corbett Scout

Map No. _____ Sec. 10 Twp. 27 R. 4Well No. 613 Farm _____

_____ Company

NORTH

WEST

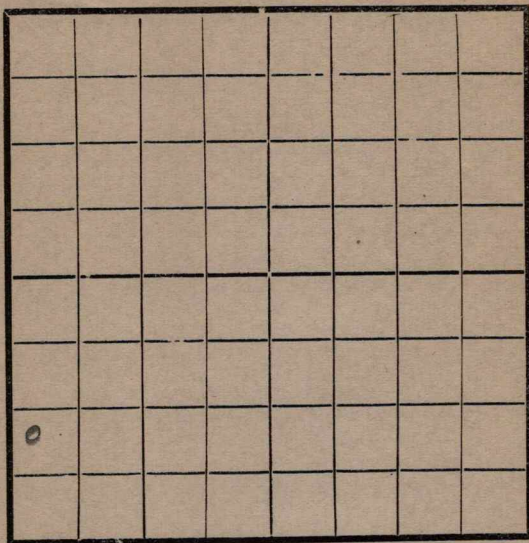

EAST

SOUTH

Location _____

Rig Up _____

Drilling and remarks

Under,
running

2140

RECORD

Cased _____ in. _____ Ft.

Sand _____

Gas _____

Oil _____

Total Depth _____

PRODUCTION

1st 24 hrs. Nat. _____

1st 24 hrs. after shot _____

Gas _____ Cu. Ft.

Dry Hole _____

Abandoned _____

Date

7/6, 191 *7* *Carney* Scout


Map No. _____ Sec. 10 Twp. 27 R. 4

Well No. 6 Bates Farm _____

Crosby Company _____

NORTH

WEST

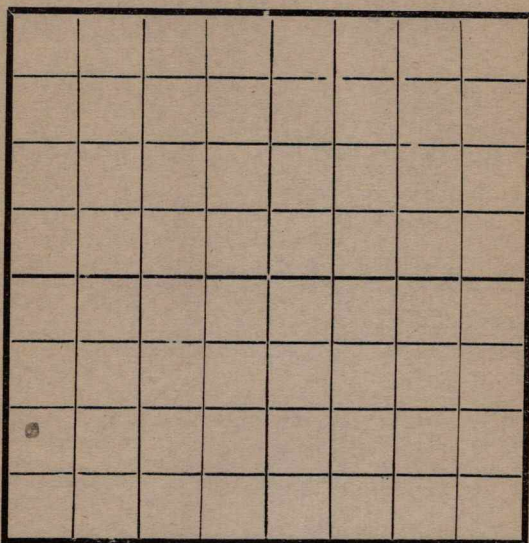

EAST

SOUTH

Location _____

Rig Up _____

Drilling and remarks

Under
running
2200

RECORD

Cased _____ in. _____ Ft.

Sand _____

Gas _____

Oil _____

Total Depth _____

PRODUCTION

1st 24 hrs. Nat. _____

1st 24 hrs. after shot _____

Gas _____ Cu. Ft.

Dry Hole _____

Abandoned* _____

Date


9/14, 1912 Crosby Scout

Map No. _____ Sec. 10 Twp. 27 R. 4Well No. 61301 Farm _____

Company _____

NORTH

WEST

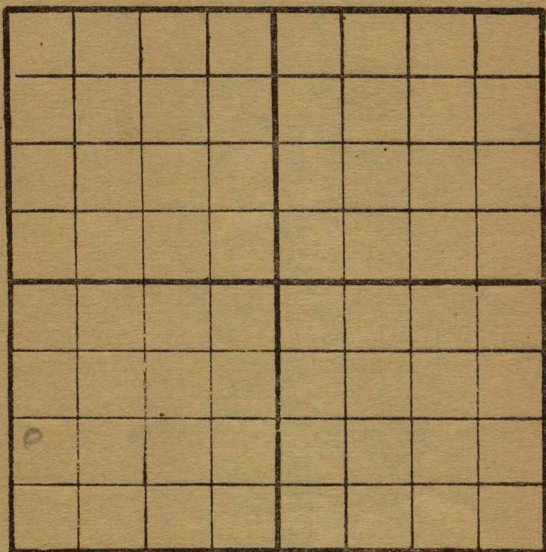

EAST

SOUTH

Location _____

Rig up _____

Drilling and remarks:

Shut Down
2300'
Repairing
Rig

RECORD

Cased _____ in. _____ Ft.

Sand _____

Gas _____

Oil _____

Total Depth _____

PRODUCTION

1st. 24 hrs. Nat. _____

1st. 24 hrs. after shot _____

Gas _____ Cu. Ft.

Dry Hole _____

Abandoned _____


Date

191

Scout

Map No. _____ Sec. 10 Twp. 27 R. 4
 Well No. 6 Bates Farm _____
Cosden Company _____

NORTH

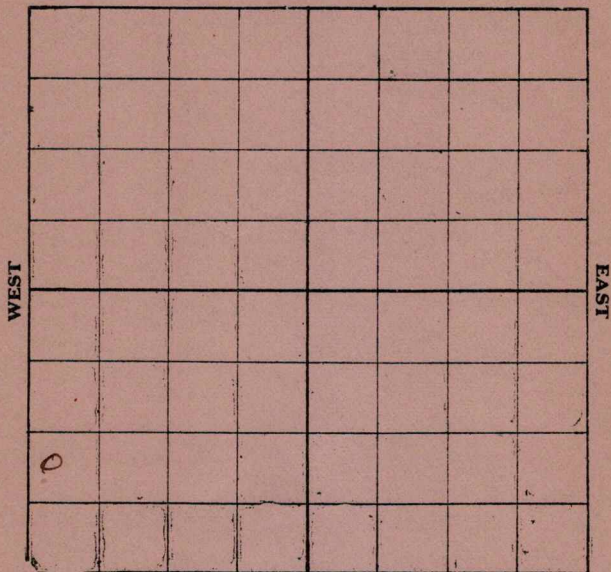

SOUTH

Location _____
 Rig up _____
 Drilling and Remarks:

Shut Down
2207'

RECORD

Cased _____ in. _____ Ft.
 Sand _____
 Gas _____
 Oil _____
 Total Depth _____

PRODUCTION

1st 24 hrs. Nat. _____
 1st 24 hrs. after shot _____
 Gas _____ Cu. Ft.
 Dry Hole _____
 Abandoned _____


Date 7/24, 1917, Cosden Scout

Map No. _____ Sec. 10 Twp. 27 R. 4Well No. 6 Bate Farm _____
Caden Company _____

NORTH

WEST

EAST

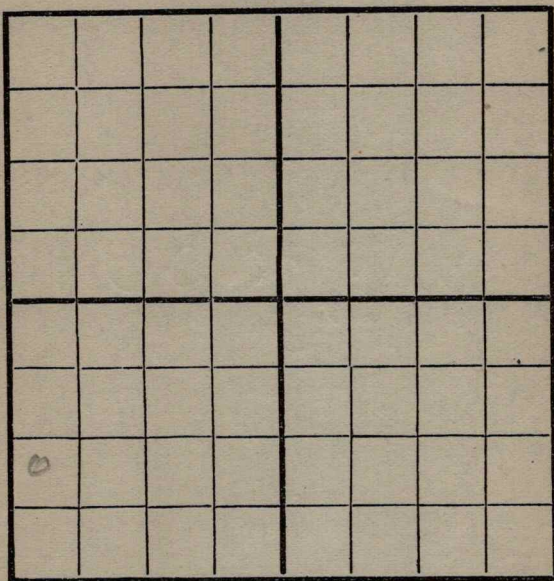

SOUTH

Location _____

Rig Up _____

Drilling and remarks

*fishing
Collopy
Casing
2200'*

RECORD

Cased _____ in. _____ Ft.

Sand _____

Gas _____

Oil _____

Total Depth _____

PRODUCTION

1st 24 hrs. Nat. _____

1st 24 hrs. after shot _____

Gas _____ Cu. Ft.

Dry Hole _____

Abandoned _____

Date

8/11, 191 *2 Caden* Scout

Map No. _____ Sec. 10 Twp. 27 R. 4Well No. 6 Bates Farm _____Cosden Company _____

NORTH

WEST

EAST

SOUTH

Location _____

Rig Up _____

Drilling and remarks

Collapsed
6 5/8"
2226

RECORD

Cased _____ in. _____ Ft.

Sand _____

Gas _____

Oil _____

Total Depth _____

PRODUCTION

1st 24 hrs. Nat. _____

1st 24 hrs. after shot _____

Gas _____ Cu. Ft.

Dry Hole _____

Abandoned _____


Date

8/17, 191 *7* *Cardiff* Scout

Map No. _____ Sec. 10 Twp. 27 R. 4Well No. C. Bates Farm _____
Cosden Company _____

NORTH

WEST

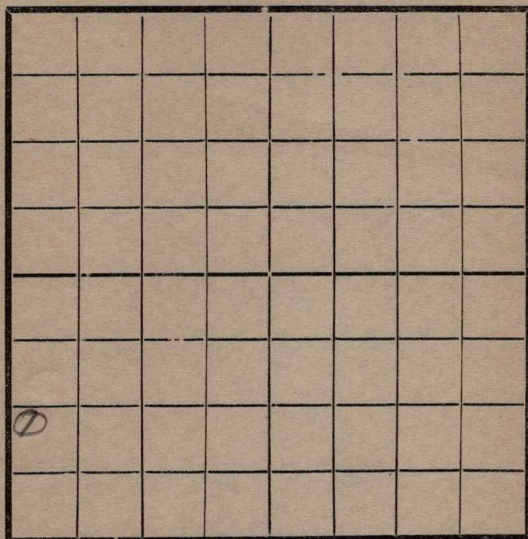

EAST

SOUTH

Location _____

Rig Up _____

Drilling and remarks

Collapsed
Csg at
2226.

RECORD

Cased _____ in. _____ Ft.

Sand _____

Gas _____

Oil _____

Total Depth _____

PRODUCTION

1st 24 hrs. Nat. _____

1st 24 hrs. after shot _____

Gas _____ Cu. Ft.

Dry Hole _____

Abandoned _____

Date


8-21, 1917 Lantz Scout

Map No. _____ Sec. 10 Twp. 27 R. 4
 Well No. 6 Bates Farm _____
Cordery Company _____

NORTH

WEST

EAST

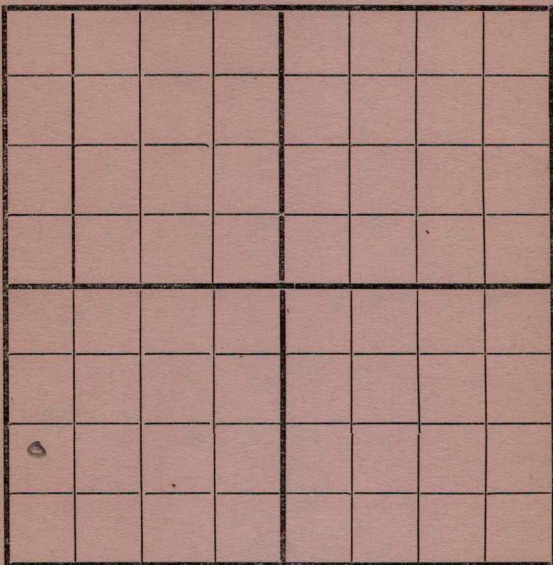

SOUTH

Location _____

Rig Up _____

Drilling and remarks

8226'
Fishing

RECORD

Cased _____ in. _____ Ft.

Sand _____

Gas _____

Oil _____

Total Depth _____

PRODUCTION

1st 24 hrs. Nat. _____

1st 24 hrs. after shot _____

Gas _____ Cu. Ft.

Dry Hole _____

Abandoned _____

Date


9/5, 1917 Cordery Scout

Map No. _____ Sec. 10 Twp. 27 R. 4Well No. 6 Bates Farm _____
Camden Company

NORTH

WEST

EAST

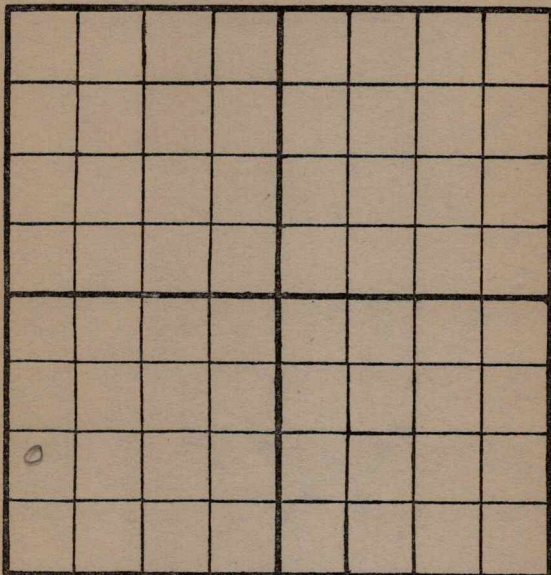

SOUTH

Location _____

Rig Up _____

Drilling and remarks

*Casing
trouble
& fishing
2226*

RECORD

Cased _____ in. _____ Ft.

Sand _____

Gas _____

Oil _____

Total Depth _____

PRODUCTION

1st 24 hrs. Nat. _____

1st 24 hrs. after shot _____

Gas _____ Cu. Ft.

Dry Hole _____

Abandoned _____

Date

9/12, 1912 Camden Scout

Map No. _____ Sec. 10 Twp. 27 R. 4Well No. 6 Bates _____ Farm _____

_____ Company _____

NORTH

WEST

EAST

SOUTH

Location _____

Rig Up _____

Drilling and remarks

Collapsed
Casing
2226

RECORD

Cased _____ in. _____ Ft.

Sand _____

Gas _____

Oil _____

Total Depth _____

PRODUCTION

1st 24 hrs. Nat. _____

1st 24 hrs. after shot _____

Gas _____ Cu. Ft.

Dry Hole _____

Abandoned _____


Date

9/19, 1917. Parkey Scout

Map No. _____ Sec. 10 Twp. 27 R. 4
 Well No. 6 Bates Farm _____
Cooden Company _____

NORTH

WEST

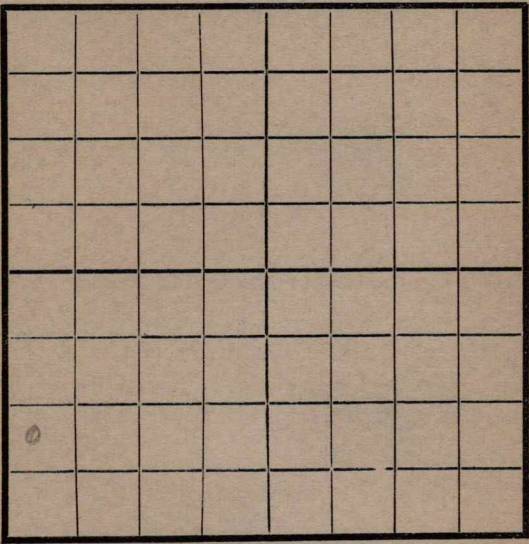

EAST

SOUTH

RECORD

Location _____
 Rig Up _____
 Drilling and remarks

Cased _____ in _____ Ft.
 Sand _____
 Gas _____
 Oil _____
 Total Depth _____

PRODUCTION


1st 24 hrs. Nat. _____
 1st 24 hrs. after shot _____
 Gas _____ Cu. Ft.
 Dry Hole _____
 Abandoned _____

*Pulling Pipe
 2226
 will skid
 Rig*

Date

9/22, 1917 Cooden Scout

Map No. _____ Sec. 10 Twp. 27 R. 4
 Well No. 6 B. 10 Farm _____
Quaker Company _____

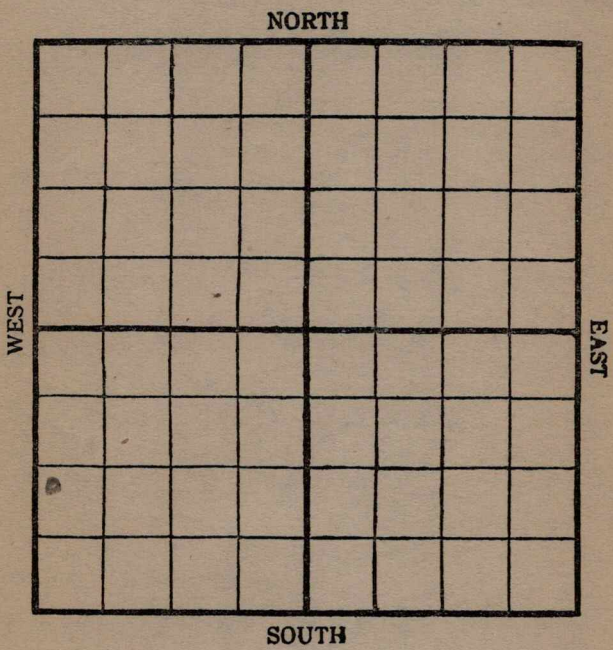

Location _____ Rig Up _____ Drilling and remarks <u>Skipped</u> <u>Rig 25 ft</u> <u>East</u>	RECORD Cased _____ in. _____ Ft. Sand _____ Gas _____ Oil _____ Total Depth _____ PRODUCTION 1st 24 hrs. Nat. _____ 1st 24 hrs. after shot _____ Gas _____ Cu. Ft. Dry Hole _____ Abandoned _____
---	--

Date 10/2, 1917, Carley Scout

Map No. _____ Sec. 10 Twp. 22 R. 4Well No. 6 Batts Farm _____

Company _____

NORTH

WEST

EAST

SOUTH

Location _____

Rig Up _____

Drilling and remarks

*Skipped
Rig lost
of abandoned
hole*

RECORD

Cased _____ in. _____ Ft.

Sand _____

Gas _____

Oil _____

Total Depth _____

PRODUCTION

1st 24 hrs. Nat. _____

1st 24 hrs. after shot _____

Gas _____ Cu. Ft.

Dry Hole _____

Abandoned _____

Date


10/9, 1917 7 Land Scout

Map No. _____ Sec. 10 Twp. 27 R. 4Well No. 6130 Farm __________
Company

NORTH

WEST

EAST

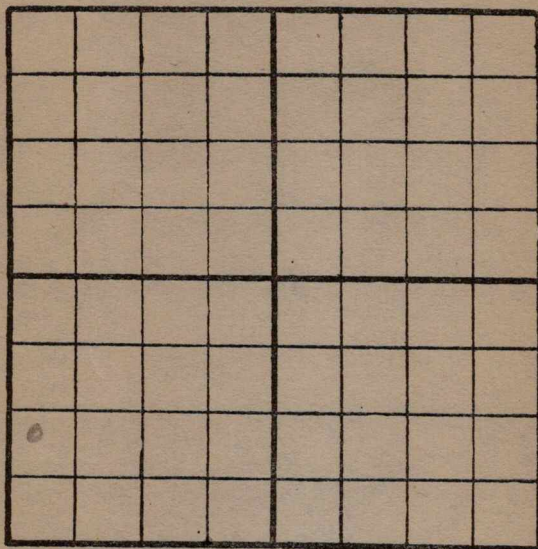

SOUTH

Location _____

Rig up ☒ _____

Drilling and remarks:

RECORD

Cased _____ in. _____ Ft.

Sand _____

Gas _____

Oil _____

Total Depth _____

PRODUCTION

1st. 24 hrs. Nat. _____

1st. 24 hrs. after shot _____

Gas _____ Cu. Ft.

Dry Hole _____

Abandoned _____


Date

10/17, 1917 W. C. Cady Scout

Map No. _____ Sec. 10 Twp. 22 R. 4Well No. 6 Bates Farm _____
Coaden Company

NORTH

WEST

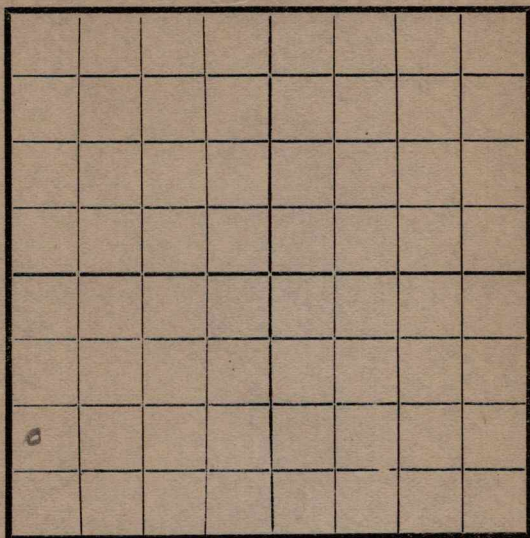

EAST

SOUTH

Location _____

Rig Up _____

Drilling and remarks

Spudding

RECORD

Cased _____ in. _____ Ft.

Sand _____

Gas _____

Oil _____

Total Depth _____

PRODUCTION

1st 24 hrs. Nat. _____

1st 24 hrs. after shot _____

Gas _____ Cu. Ft.

Dry Hole _____

Abandoned _____


Date

10/24, 1917 Carroll Scout

Map No. _____ Sec. 10 Twp. 27 R. 4Well No. 6 Bates Farm _____
Cummins Company

NORTH

WEST

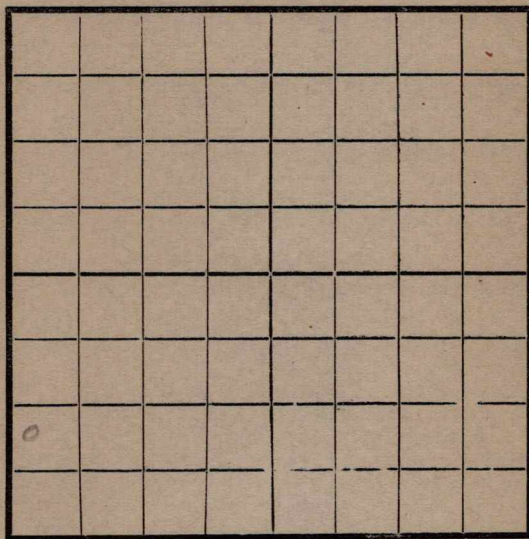

EAST

SOUTH

Location _____

Rig Up _____

Drilling and remarks

500'

RECORD

Cased _____ in. _____ Ft.

Sand _____

Gas _____

Oil _____

Total Depth _____

PRODUCTION

1st 24 hrs. Nat. _____

1st 24 hrs. after shot _____

Gas _____ Cu. Ft.

Dry Hole _____

Abandoned _____


Date

10/31, 1917, Cummins Scout

Map No. _____ Sec. 10 Twp. 27 R. 4Well No. 6 Bates Farm _____Casden Company _____

NORTH

WEST

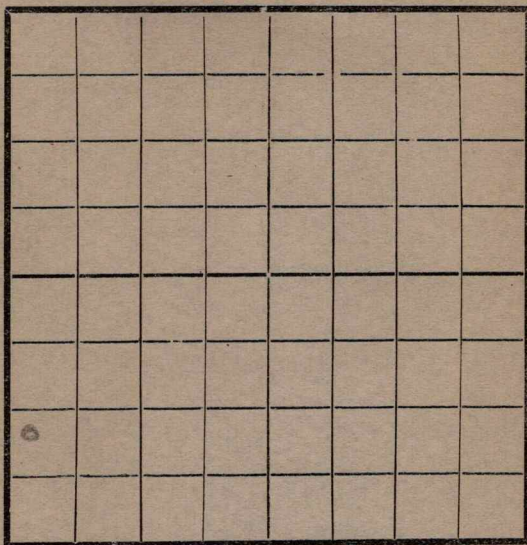

EAST

SOUTH

Location _____

Rig Up _____

Drilling and remarks

700

RECORD

Cased _____ in. _____ Ft.

Sand _____

Gas _____

Oil _____

Total Depth _____

PRODUCTION

1st 24 hrs. Nat. _____

1st 24 hrs. after shot _____

Gas _____ Cu. Ft.

Dry Hole _____

Abandoned _____

Date

7/19, 1917 Casden Scout

Map No. _____ Sec. 10 Twp. 27 R. 4

Well No. 625 Farm _____

Company

NORTH

WEST

EAST

SOUTH

Location _____

Rig Up -----

Drilling and remarks

1185'

RECORD

Cased_____ in. _____ Ft.

Sand

Gas

Oil

Total Depth -----

PRODUCTION

1st 24 hrs. Nat.-----

1st 24 hrs. after shot-----

Gas _____ Cu. Ft.

Dry Hole -----

Abandoned -----

Date _____


11-14 7 Candice Scout

Map No. _____ Sec. 10 Twp. 27 R. 4Well No. 6 Bates Farm _____

Company _____

NORTH

WEST

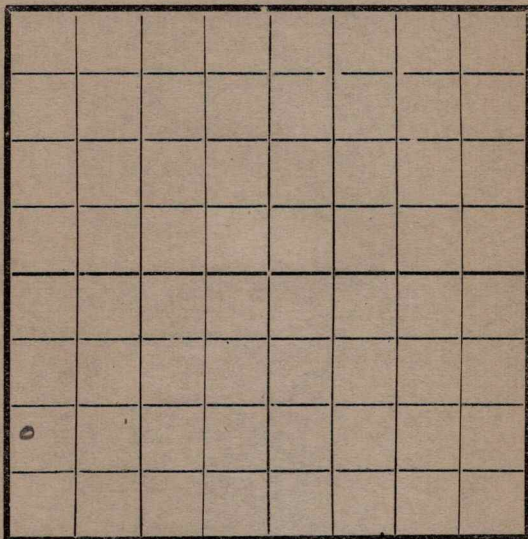

EAST

SOUTH

Location _____

Rig Up _____

Drilling and remarks

1370

RECORD

Cased _____ in. _____ Ft.

Sand _____

Gas _____

Oil _____

Total Depth _____

PRODUCTION

1st 24 hrs. Nat. _____

1st 24 hrs. after shot _____

Gas _____ Cu. Ft.

Dry Hole _____

Abandoned _____


Date

11/21, 1917 Cordell Scout

Map No. _____ Sec. 10 Twp. 27 R. 4Well No. 6 Bate Farm _____
Cosden Company _____

NORTH

WEST

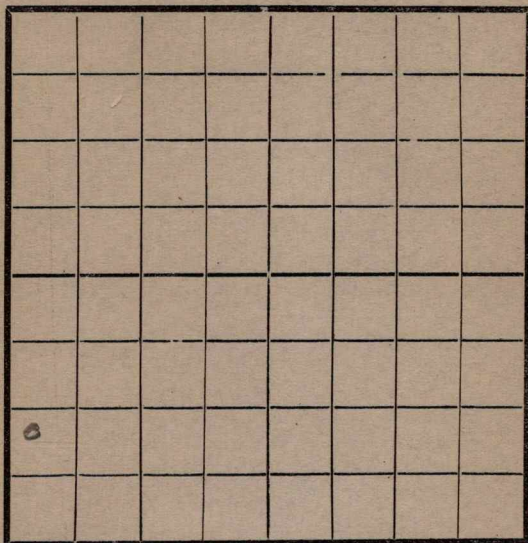

EAST

SOUTH

Location _____

Rig Up _____

Drilling and remarks

RECORD

Cased _____ in. _____ Ft.

Sand _____

Gas _____

Oil _____

Total Depth _____

PRODUCTION

1st 24 hrs. Nat. _____

1st 24 hrs. after shot _____

Gas _____ Cu. Ft.

Dry Hole _____

Abandoned _____


Date

11/28, 1917 Cosden Scout _____

Map No. _____ Sec. 10 Twp. 27 R. 4Well No. 6 Bates Farm _____Cusden Company _____

NORTH

WEST

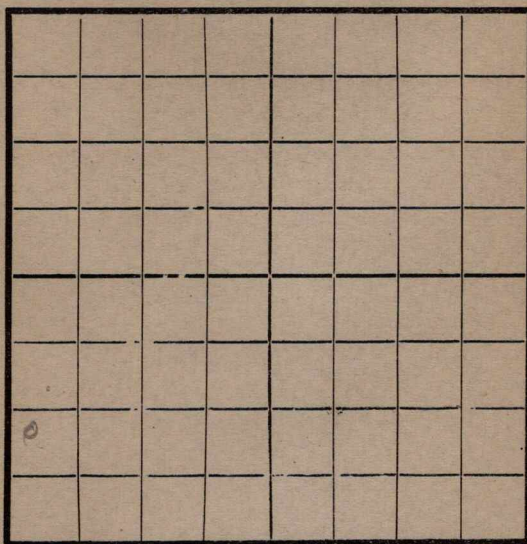

EAST

SOUTH

Location _____

Rig Up _____

Drilling and remarks

1940

RECORD

Cased _____ in. _____ Ft.

Sand _____

Gas _____

Oil _____

Total Depth _____

PRODUCTION

1st 24 hrs. Nat. _____

1st 24 hrs. after shot _____

Gas _____ Cu. Ft.

Dry Hole _____

Abandoned _____


Date

12/5, 191 2 Cusden Scout

Map No. _____ Sec. 10 Twp. 27 R. 4Well No. 6 Bate Farm _____
Candler Company

NORTH

WEST

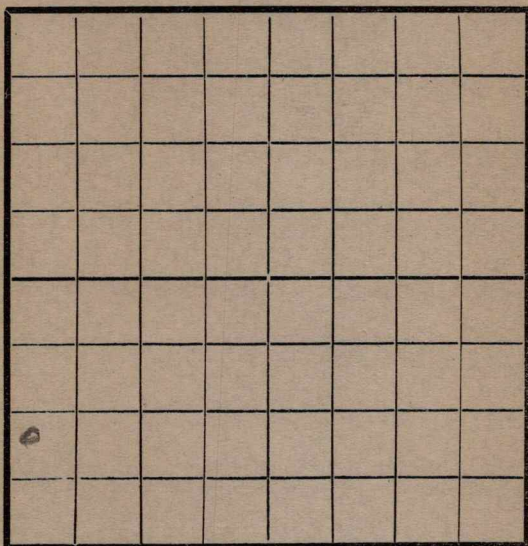

EAST

SOUTH

Location _____

Rig Up _____

Drilling and remarks

22
2000'

RECORD

Cased _____ in. _____ Ft.

Sand _____

Gas _____

Oil _____

Total Depth _____

PRODUCTION

1st 24 hrs. Nat. _____

1st 24 hrs. after shot _____

Gas _____ Cu. Ft.

Dry Hole _____

Abandoned _____


Date

12/27, 1917 Candler Scout

Map No. _____ Sec. 10 Twp. 27A R. 4EWell No. 6 H.C. Bates Farm
Cosden Company

NORTH

WEST

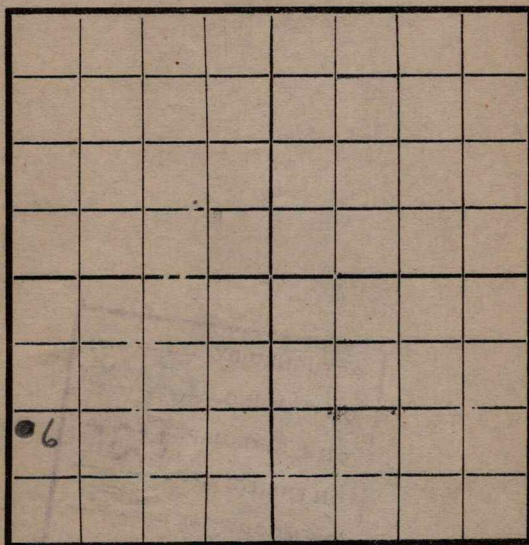

EAST

SOUTH

RECORD

Location _____

Cased _____ in. _____ Ft.

Rig Up _____

Sand _____

Drilling and remarks

Gas _____

Oil _____

Total Depth _____

PRODUCTION

1st 24 hrs. Nat. 40

1st 24 hrs. after shot _____

Gas _____ Cu. Ft.

Dry Hole _____

Abandoned _____

Date

12-17, 1917 Bax Scout


Map No. _____ Sec. 10 Twp. 27 R. 4

Well No. 6 Bates Farm _____

Cowan Company _____

NORTH

WEST

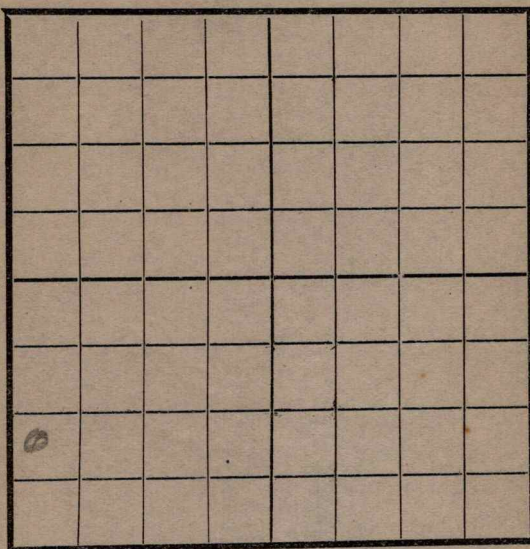

EAST

SOUTH

Location _____

Rig Up _____

Drilling and remarks

22 2000

RECORD

Cased _____ in. _____ Ft.

Sand _____

Gas _____

Oil _____

Total Depth _____

PRODUCTION

1st 24 hrs. Nat. _____

1st 24 hrs. after shot _____

Gas _____ Cu. Ft.

Dry Hole _____

Abandoned _____

Date


12/19, 1917 Cowley

Scout

Map No. _____ Sec. 10 Twp. 27 R. 4Well No. 6 Bates _____ Farm
Cassidy _____ Company

NORTH

WEST

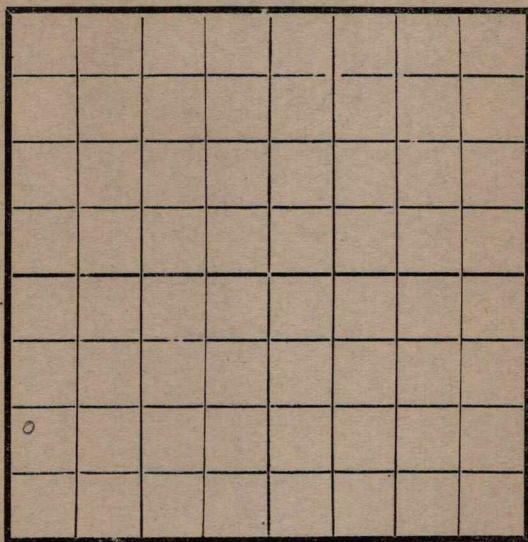

EAST

SOUTH

Location _____

Rig Up _____

Drilling and remarks

Top sand2415CableMeasure

RECORD

Cased _____ in. _____ Ft.

Sand _____

Gas _____

Oil _____

Total Depth _____

PRODUCTION

1st 24 hrs. Nat. _____

1st 24 hrs. after shot _____

Gas _____ Cu. Ft.

Dry Hole _____

Abandoned _____


Date

1/4, 1918 Cassidy Scout

Map No. _____ Sec. 10 Twp. 27 R. 4Well No. 6 Bates Farm _____
Casden Company

NORTH

WEST

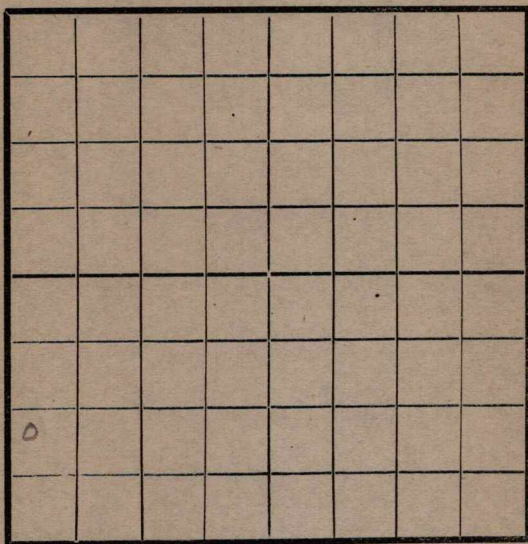

EAST

SOUTH

RECORD

Location _____

Cased _____ in. _____ Ft.

Rig Up _____

Sand _____

Drilling and remarks

Gas _____

Oil _____

Total Depth _____

PRODUCTION

1st 24 hrs. Nat. _____

1st 24 hrs. after shot _____

Gas _____ Cu. Ft.

Dry Hole _____

Abandoned _____


Date

1/9, 1918 J. Casden ScoutPulling 10" casing

Map No. _____ Sec. 10 Twp. 27 R. 4Well No. 6 Bates Farm _____
Cassidy Company

NORTH

WEST

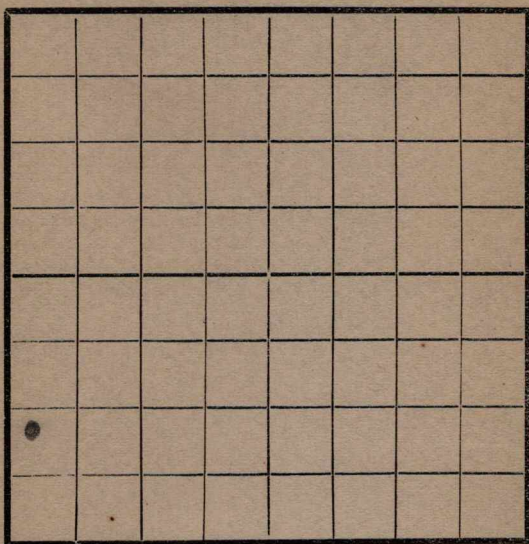

SOUTH

Location _____

Rig Up _____

Drilling and remarks

*SD on top
sand
2418'*

RECORD

Cased _____ in. _____ Ft.

Sand _____

Gas _____

Oil _____

Total Depth _____

PRODUCTION

1st 24 hrs. Nat. _____

1st 24 hrs. after shot _____

Gas _____ Cu. Ft.

Dry Hole _____

Abandoned _____


Date

1/16, 1918 *Cassidy* Scout

Map No. T887 R11 Sec. 10 Twp. 27 R. 4
Well No. 6 Bates Farm
Doonan Company

NORTH

WEST

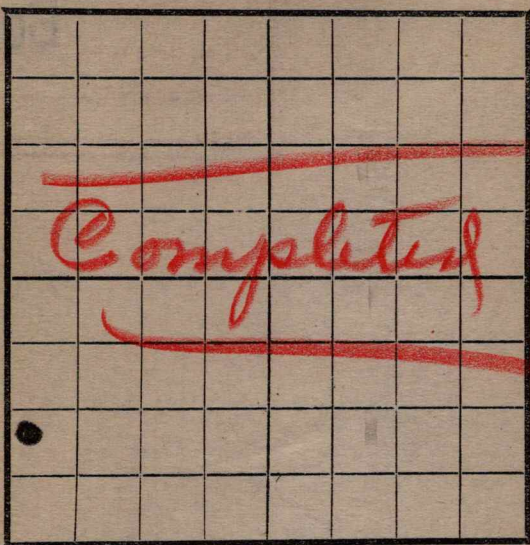

EAST

SOUTH

RECORD

Location _____
Rig Up _____
Drilling and remarks

Cased _____ in _____ Ft.
Sand 2418-2459
Gas _____
Oil _____
Total Depth _____

*Estimated
at 300 bbls*

PRODUCTION

1st 24 hrs. Nat. _____
1st 24 hrs. after shot _____
Gas _____ Cu. Ft.
Dry Hole _____
Abandoned _____

Date

1/23, 1918 Conley Scout

ACCOUNTING DEPARTMENT

SCOUTING

"

ENGINEERING

"

Tulsa, Okla.,

RENTAL

"

LEGAL

"

Jan. 29, 1918.

Building.

Gentlemen:

This is to advise you that Well No. 6 located in _____
_____ of H C BATES
Lease, described as South half of the SW/4 of
_____ Section 10, Township 27-S, Range 4-E
was completed on January 26th., 1918, at a total depth of
2459 feet, and is good for an oil well, with
estimated production of _____ per day.

We have already completed arrangements with _____
_____ Pipe Line Company to take care of the oil.

Remarks: Drilling completed Jan. 19, 1918.

Commenced pumping Jan. 24, 1918.

Pumped 372 barrels first 24 hours.

Yours very truly,

Comstock