


Section 26 Township 28 Range 3E

Well No. 11 Hawks

Company Padco & Sohio

Misc.
NORTH

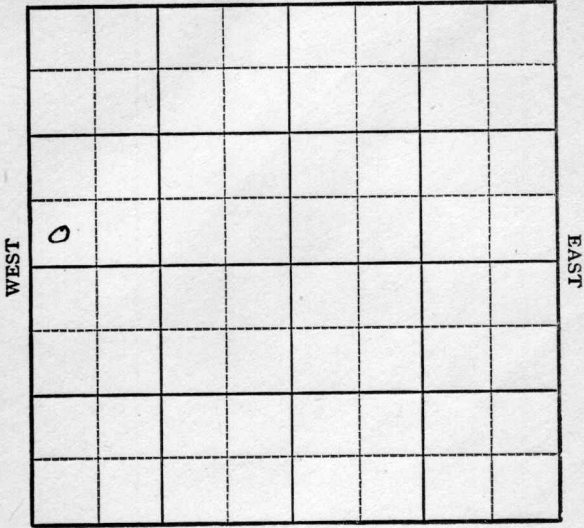

SOUTH

Sec. 26 Twp. 28 R. 3-E

Well No. #11 Hawks Farm _____

Padco & Sohio Company
Miscellaneous


_____ Ft. from N. Line

330 Ft. from S. Line

_____ Ft. from E. Line

330 Ft. from W. Line

SW NW

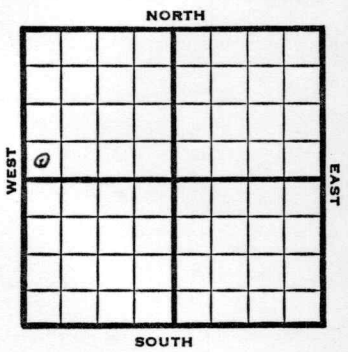

1948 Eli 1315' REPORT

11/3 Drlg 100
11/10 8" @ 163'
KC 2295'
Drlg 2470'

11/16 TD 2965'
5" @ 2965'

11/23 Simpson 2985#97'
TD 2997'
SO&W

12/1 PB 2993'
TD 2997'
Simp 2985'
5" @ 2965'
Pump 25 Oil Pot
41 Gr.
Comp

COMPLETED

Map No. _____ Sec. 26 Twp. 28 R. 3E

Well No. 11 Hawks

Padco & Sohio Company

FIRST REPORT Contractor

SW NW

SECTION PLAT

_____ Ft. from N. Line

330 Ft. from S. Line

_____ Ft. from E. Line

330 Ft. from W. Line

Butler County

Location _____

Rig up _____

Drilling and Remarks:

drlg. 100

RECORD

Cased _____ in., _____ ft.

Sand _____

Gas _____

Oil _____

Total Depth _____

PRODUCTION

1st 24 hrs. Nat. _____

1st 24 hrs. after shot _____

Gas _____ Cu. Ft.

Dry Hole _____

Abandoned _____

Date

NOV 3 1948 19

S. J. LEWIS

Scout

