


Section 26 Township 28 Range 3E

Well No. 13 Hawks

Company Padco & Sohio

Misc.
NORTH

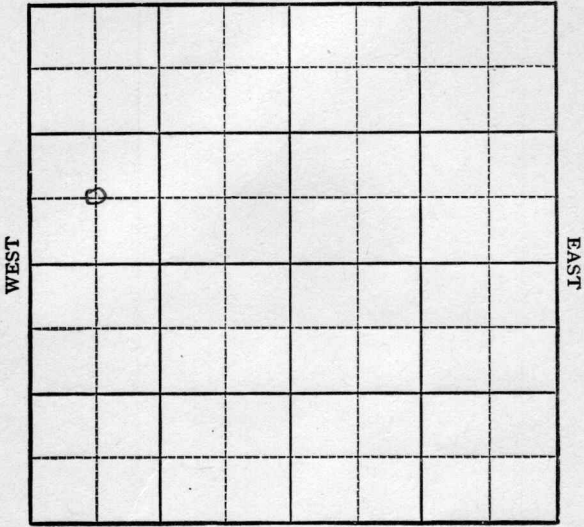

SOUTH

KANSAS

Butler

Sec. 26 Twp. 28 R. 3E ✓

Well No. #13 Hawks Farm _____
Padco & Sohio Company _____

Miscellaneous


_____ Ft. from N. Line

660' Ft. from S. Line

_____ Ft. from E. Line

660' Ft. from W. Line

C SW NW

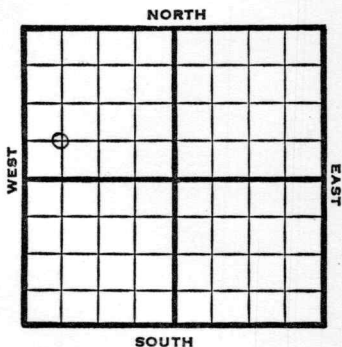

1948

Eli 1312'

REPORT

12/15

8" @ 175'
KC 2298'
Drlg. 2545'

12/22

Miss 2765'
TD 2960'

12/29

5" @ 2960'
TD 2984'
Simp 2977'
Aband

ABANDONED

Map No. _____ Sec. 26 Twp. 28 R. 3E

Well No. 13 Hawks

Padco & Sohio Company

FIRST REPORT Contractor

C SW NW

SECTION PLAT

_____ Ft. from N. Line

660 Ft. from S. Line

_____ Ft. from E. Line

660 Ft. from W. Line

Butler County

Location _____

Rig up _____

Drilling and Remarks:

8" @ 175

KC 2298

drlg. 2545

RECORD

Cased _____ in., _____ ft.

Sand _____

Gas _____

Oil _____

Total Depth _____

PRODUCTION

1st 24 hrs. Nat. _____

1st 24 hrs. after shot _____

Gas _____ Cu. Ft.

Dry Hole _____

Abandoned _____

Date

DEC 15 1948

19

S. J. LEWIS

Scout

Map No. 12 Sec. 26 Twp. 28 R. 3E

Well No. 13 Hawks

Pabco & Sohio Company

ABANDONED Contractor

C SW NW

E. 13/2

SECTION PLAT

 Ft. from N. Line

660 Ft. from S. Line

 Ft. from E. Line

660 Ft. from W. Line

o			

Butler County

RECORD

Location

Rig up

Drilling and Remarks:

Shut 2977

Cased in., ft.

Sand

Gas

Oil

Total Depth 2984

PRODUCTION

1st 24 hrs. Nat.

1st 24 hrs. after shot

Gas Cu. Ft.

Dry Hole

Abandoned

Date

DEC 29 1948

19

S. J. LEWIS

Scout