


KANSAS

Butler

Section 27 Township 28S Range 3E

Well No. #15 Hawks

Company Pabco & Sohio

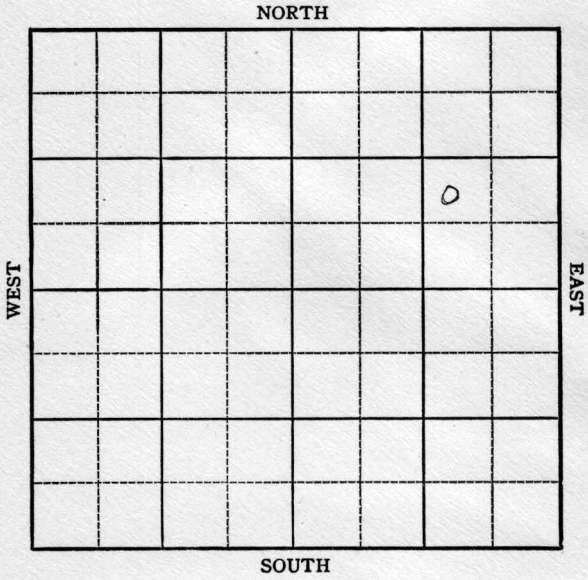

KANSAS

Butler

Sec. 27 Twp. 28 R. 3E ✓

Well No. #15 Hawks Farm

Pabco & Sohio Company

Miscellaneous


_____ Ft. from N. Line

990' Ft. from S. Line

990' Ft. from E. Line

_____ Ft. from W. Line

NW SE NE

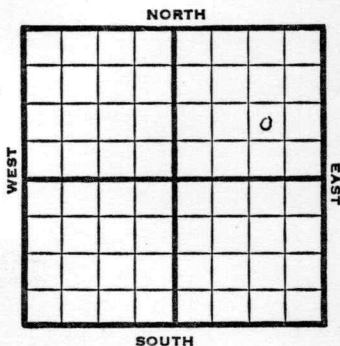

1949 Elev 1291' REPORT

2/9 RUR

2/16 8" @ 170'
Drlg. 2400'

2/23 TD 2950'
5" @ 2950'

3/2 TD 2976'
Simp 2968'
5" @ 2950'
Pump 25 Oil Pot
46° Gr.
Comp

COMPLETED

Map No. _____ Sec. 27 Twp. 28 R. 3E

Well No. 15 Hawks

Paber & Schio Company

FIRST REPORT Contractor

NWSENE

SECTION PLAT

| | | | |
|--|--|--|---|
| | | | |
| | | | 0 |
| | | | |
| | | | |

_____ Ft. from N. Line

990 Ft. from S. Line

990 Ft. from E. Line

_____ Ft. from W. Line

Butler

Location _____

Rig up _____

Drilling and Remarks:

RUR

RECORD

Cased _____ in., _____ ft.

Sand _____

Gas _____

Oil _____

Total Depth _____

PRODUCTION

1st 24 hrs. Nat. _____

1st 24 hrs. after shot _____

Gas _____ Cu. Ft.

Dry Hole _____

Abandoned _____

Date

FEB 9 1949

S. J. LEWIS Scout

