


Section 27 Township 28 Range 3E

Well No. 1 Hawks "B"

Company Talbott & Sohio

Misc.

NORTH

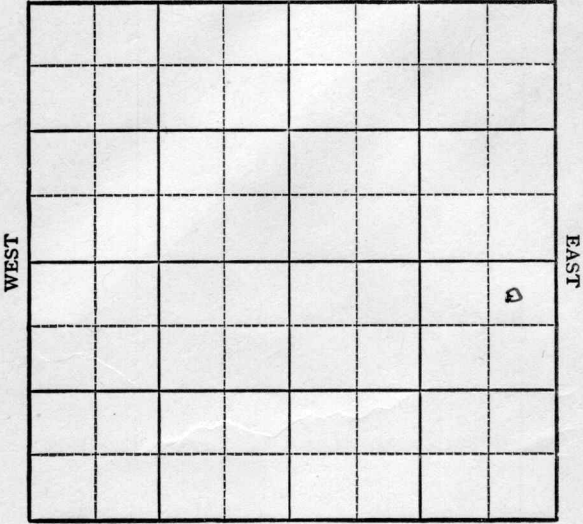

SOUTH

KANSAS

Butler

Sec. 27 Twp. 28 R. 3E ✓

Well No. #1 Hawks "B" Farm

Talbott & Sohio Company


Miscellaneous

330' Ft. from N. Line

\_\_\_\_\_ Ft. from S. Line

330' Ft. from E. Line

\_\_\_\_\_ Ft. from W. Line

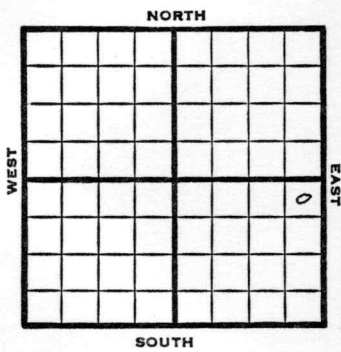

NE SE

SOUTH

1948 Elev. 1301' REPORT

12/15 Spud

12/22 8" @ 154'  
Drlg. 1300'

12/29 Miss 2752'  
5" @ 2955'  
Simpson 2974'  
TD 2982'

1949  
1/5 Simp. 2974'  
5" @ 2955'  
Pump 75 oil Pot.  
Gr. 40°  
TD 2982'

**COMPLETED**

Map No. \_\_\_\_\_ Sec. 27 Twp. 28 R. 3E

Well No. 1 Hawks "B"

Talbott & Sohio Company

**FIRST REPORT**

Contractor

NE SE

**SECTION PLAT**

330 Ft. from N. Line

\_\_\_\_\_ Ft. from S. Line

330 Ft. from E. Line

\_\_\_\_\_ Ft. from W. Line


Butler County

Location \_\_\_\_\_

Rig up \_\_\_\_\_

Drilling and Remarks:

Spud

**RECORD**

Cased \_\_\_\_\_ in., \_\_\_\_\_ ft.

Sand \_\_\_\_\_

Gas \_\_\_\_\_

Oil \_\_\_\_\_

Total Depth \_\_\_\_\_

**PRODUCTION**

1st 24 hrs. Nat. \_\_\_\_\_

1st 24 hrs. after shot \_\_\_\_\_

Gas \_\_\_\_\_ Cu. Ft.

Dry Hole \_\_\_\_\_

Abandoned \_\_\_\_\_

Date

DEC 15 1948

S. J. LEWIS

Scout

Map No. 12 Sec. 27 Twp. 28 R. 3E

Well No. 1 Hawks "B"

Talbott & Sohio Company

**COMPLETE**

Contractor

NE SE

*E 11301*

**SECTION PLAT**

330 Ft. from N. Line

\_\_\_\_\_ Ft. from S. Line

330 Ft. from E. Line

\_\_\_\_\_ Ft. from W. Line

			o

Butler County

Location \_\_\_\_\_

Rig up \_\_\_\_\_

Drilling and Remarks:

*Swif 2574  
OK @ 2950*

*Prod 75 oil*

*48° S*

**RECORD**

Cased \_\_\_\_\_ in., \_\_\_\_\_ ft.

Sand \_\_\_\_\_

Gas \_\_\_\_\_

Oil  \_\_\_\_\_

Total Depth 2950

**PRODUCTION**

1st 24 hrs. Nat. \_\_\_\_\_

1st 24 hrs. after shot \_\_\_\_\_

Gas \_\_\_\_\_ Cu. Ft.

Dry Hole \_\_\_\_\_

Abandoned \_\_\_\_\_

Date

JAN 5 1949 19

S. J. LEWIS Scout