

Section 27 Township 28 Range ~~2E~~ ^{3E}

Well No. 2 Hawks "B"


Company Talbott & Sohio

Misc.

NORTH

WEST

EAST

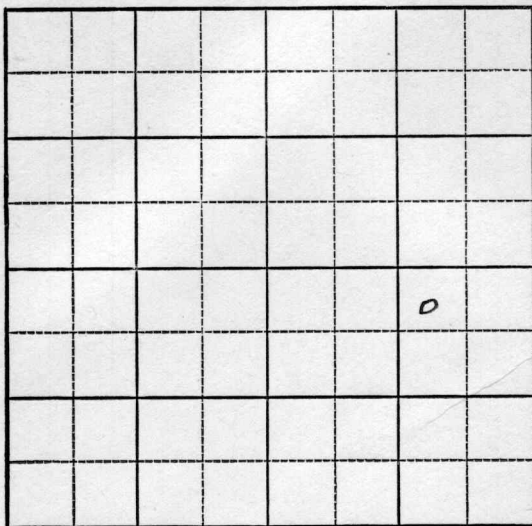

SOUTH

KANSAS Butler

Sec. 27 Twp. 28 R. 3E ~~4E~~

Well No. #2 - Hawks "B" Farm

Talbott & Sohio Company

Miscellaneous


330' Ft. from N. Line

_____ Ft. from S. Line

990' Ft. from E. Line

_____ Ft. from W. Line

NW NE SE

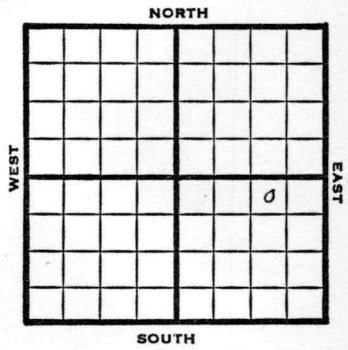

1949 Elev. 1291' REPORT

2/2 8" @ 167'
 2/9 Drlg 1820'
 2/16 Simp. 2966'
 TD 2973'
ABANDONED

Map No. _____ Sec. 27 Twp. 28 R. 4E

Well No. 2 Hawks "B"

Talbott & Sohio Company

FIRST REPORT Contractor

NW NE SE

SECTION PLAT

330 Ft. from N. Line

_____ Ft. from S. Line

990 Ft. from E. Line

_____ Ft. from W. Line

			o

Butler County

Location _____

Rig up _____

Drilling and Remarks:

8" @ 167

RECORD

Cased _____ in., _____ ft.

Sand _____

Gas _____

Oil _____

Total Depth _____

PRODUCTION

1st 24 hrs. Nat. _____

1st 24 hrs. after shot _____

Gas _____ Cu. Ft.

Dry Hole _____

Abandoned _____

Date

FEB 2 1949 19

S. J. LEWIS

Scout

Miscellaneous

Map No. K12 Sec. 27 Twp. 28 R. 3E

Well No. 2 Hawks B.

Talbot & Sohio Company

CORRECTION Contractor

NW 1/4 SE

SECTION PLAT

330 Ft. from N. Line

_____ Ft. from S. Line

590 Ft. from E. Line

_____ Ft. from W. Line

			o

Butter

Location _____

Rig up _____

Drilling and Remarks:

Reperced

27-28-4E

RECORD

Cased _____ in., _____ ft.

Sand _____

Gas _____

Oil _____

Total Depth _____

PRODUCTION

1st 24 hrs. Nat. _____

1st 24 hrs. after shot _____

Gas _____ Cu. Ft.

Dry Hole _____

Abandoned _____

Date

FEB 9 1949 19

S. J. LEWIS Scout

Map No. K12 Sec. 27 Twp. 28 R. 3E

Well No. 2 Hawks "B"

Talbott & Sohio Company

ABANDONED Contractor

NW NE SE

E61291
SECTION PLAT

330 Ft. from N. Line

_____ Ft. from S. Line

990 Ft. from E. Line

_____ Ft. from W. Line

			5

Butler County

Location _____

Rig up _____

Drilling and Remarks:

Sing 2966

RECORD

Cased _____ in., _____ ft.

Sand _____

Gas _____

Oil _____

Total Depth 2928

PRODUCTION

1st 24 hrs. Nat. _____

1st 24 hrs. after shot _____

Gas _____ Cu. Ft.

Dry Hole _____

Abandoned _____

Date

FEB 16 1949 19

S. J. LEWIS Scout