


KANSAS

Section 14 Township 24 Range 12EWell No. #31 Geo. WayhamCompany Mid-Continent Petr.

NORTH

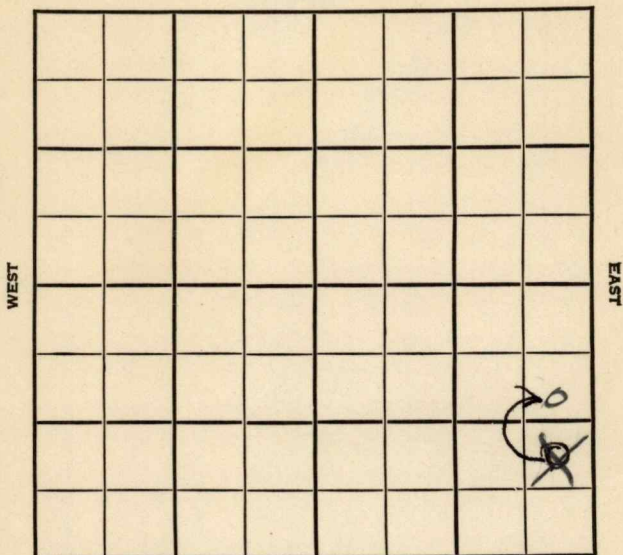

SOUTH

KANSAS

Hot File
Greenwood

Sec. 14 Twp. 24 R. 12E

Well No. #31 Geo. Wayham Farm

Mid-Continent Petr.

Company

Virgil Pool

990' Ft. from N. Line

990' Ft. from S. Line


330' Ft. from E. Line

Ft. from W. Line

NE SE SE

SE NE

1800 Foot Test

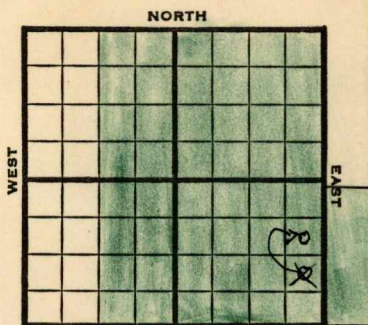

1948

REPORT

6/9	Location	
6/15	Spudded 6-14-48	
	Set 20' 12 $\frac{1}{2}$ " casing with 32 sacks. (PR)	
6/16	WOC	"
6/17	WOC	
	TD 21'	"
6/18	Drilling 1344'	"
6/21	Set 7" at 1740' with 50 sacks.	
	TD 1745'	"
6/22	WOC	
	TD. 1745'	"
6/23	Drilling cement.	
	TD. 1745'	"
6/24	Show oil 1748'-49'	
	Drilling 1749'	"
6/25	Drilling 1749' NR.	"
6/28	Comp. 6-28-48 10 Bpd.	
	TD. 1749'	"
6/30	Corrected TD. 1753'	"

OVER

1948

6/30 7" @ 1740 $\frac{1}{2}$

Acid 2000

Pump 10 oil & W Pot.

Gr. 38°

Top Miss gone

TD 1745 in Miss

COMPLETED

Map No. _____ Sec. 14 Twp. 24 R. 12E

Well No. 31 Geo. Wayham

Mid-Continent Petroleum Company

FIRST REPORT Contractor

NE SE SE

SECTION PLAT

			o

_____ Ft. from N. Line

990 Ft. from S. Line

330 Ft. from E. Line

_____ Ft. from W. Line

Greenwood County

Location X

Rig up _____

Drilling and Remarks:

RECORD

Cased _____ in., _____ ft.

Sand _____

Gas _____

Oil _____

Total Depth _____

PRODUCTION

1st 24 hrs. Nat. _____

1st 24 hrs. after shot _____

Gas _____ Cu. Ft.

Dry Hole _____

Abandoned _____

Date

JUN 9 1948 19 S. J. LEWIS Scout

Map No. 16 Sec. 14 Twp. 24 R. 12E

Well No. 31 Geo. Wayham

Mid-Continent Petroleum Company
CORRECTION

Contractor

SE NE SE

SECTION PLAT

			o

990 Ft. from N. Line

Ft. from S. Line

330 Ft. from E. Line

Ft. from W. Line

Greenwood County

Location

Rig up

Drilling and Remarks:

Reported

NE SE SE

RECORD

Cased in., ft.

Sand

Gas

Oil

Total Depth

PRODUCTION

1st 24 hrs. Nat.

1st 24 hrs. after shot

Gas Cu. Ft.

Dry Hole

Abandoned

Date

JUN 16 1948 19

S. J. LEWIS Scout

Map No. 16 Sec. 14 Twp. 24 R. 12E

Well No. 31 Geo. Wayham

Mid-Continent Petroleum Company

COMPLETE

Contractor

SE NE SE

SECTION PLAT

			o

990 Ft. from N. Line

 Ft. from S. Line

330 Ft. from E. Line

 Ft. from W. Line

Greenwood County

Location

Rig up

Drilling and Remarks:

7" C 1740 1/2

2000 acd

Pump 10 oil + SW

2735-22

The Well gone.

Date

RECORD

Cased in., ft.

Sand

Gas

Oil

Total Depth 1745 in this

PRODUCTION

1st 24 hrs. Nat.

1st 24 hrs. after shot

Gas Cu. Ft.

Dry Hole

Abandoned

JUN 30 1948 19 S. J. LEWIS