


Greenwood
FORM 51-5M-6-29-PETROL
Map No. **KANSAS** Sec. 16 Twp. 24 R. 12E
Well No. 1-Johnson Farm
Pravil & Parrish Company

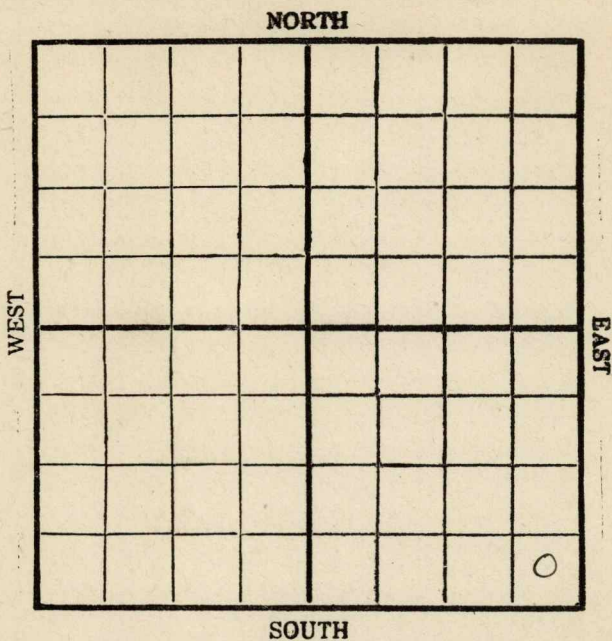

Location _____ Drilling Remarks _____ _____	Rig Up _____ Drilling Remarks _____ _____ _____ _____ _____ _____ _____ _____ _____ _____ _____ _____ _____ _____ _____ _____ _____ _____ _____ _____
RECORD	PRODUCTION
Cased _____ in. _____ ft.	1st 24 hrs. Nat. _____
Sand _____	1st 24 hrs. after shot _____
Gas _____	Gas _____ cu. ft. _____
Oil _____	Dry Hole _____
Total Depth _____	Abandoned _____


Map No. **KANSAS** Sec. 16 Twp. 24 R. 12^E
Well No. 1-Johnson Farm
Prairie and Parrish Company

_____ Ft. from N. Line

330 Ft. from S. Line

330 Ft. from E. Line

_____ Ft. from W. Line

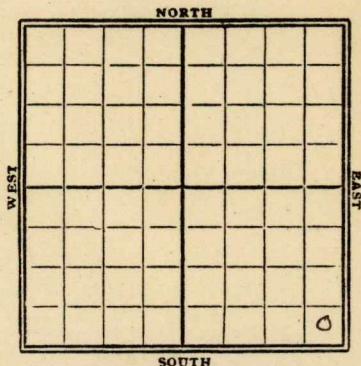

1929

Date

REPORT

8/14 Only 1200'
8/21 sand 1674-81
PB to 1680-will shoot
8/28 —
9/4 sand 1482-1506'
TD. 1681'
shot 60 qt
60 bbl oil
Corp.

Map No. **KANSAS** Sec. 16 Twp. 24 R. 12EWell No. 1 JohnsonPrairie & Passin Company

Contractor

FIRST REPORTS Ft. from N. Line330 Ft. from S. Line330 Ft. from E. Line Ft. from W. Line**SECTION PLAT**

			0

Location Rig up

Drilling and Remarks:

Dr. 1200**RECORD**Cased in., ft.Sand Gas Oil Total Depth **PRODUCTION**1st 24 hrs. Nat. 1st 24 hrs. after shot Gas Cu. Ft.Dry Hole Abandoned

Date

AUG 14 1929**CHAS. L. SHERWOOD**

Scout

16 **KANSAS** Greenwood
 Map No. Sec. 16 Twp. 24 R. 12

Well No. 1 Johnson
 prairie & farish Company
 Contractor

COMPLETE

____ Ft. from N. Line

330 Ft. from S. Line330 Ft. from E. Line

____ Ft. from W. Line

SECTION PLAT

			0

Location _____

Rig up _____

Drilling and Remarks:

RECORD

Cased _____ in., _____ ft.

Sand 1482-1506

Gas _____

Oil _____

Total Depth 1681**PRODUCTION**

1st 24 hrs. Nat. _____

1st 24 hrs. after shot _____

Gas _____ Cu. Ft.

Dry Hole _____

Abandoned _____

Date

SEP 4 1929