

Section 14 Township 24 Range 12EWell No. #25, George WayhanCompany Mid-Continent Petr. Corp.

NORTH


SOUTH

WEST EAST

0

Sec. 14 Twp. 24 R. 12EWell No. #25 George Wayham FarmMid-Continent Petr. Corp. Company

Virgil

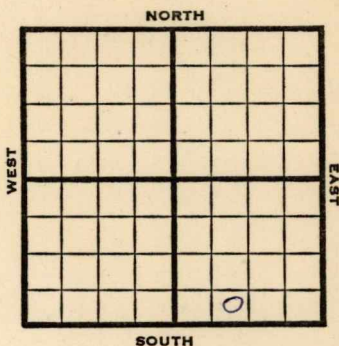 Ft. from N. Line330 Ft. from S. Line Ft. from E. Line990 Ft. from W. Line

SE SW SE

1946

REPORT

4/17	9-5/8" @ 21 Drlg. 185'	
4/20	Drilling 1460'	(Daily report)
4/22	7" set 1733' with 50 sacks.	"
4/23	Top Line 1731' WOC	
4/24	Spudded 4-14-46 WOC	
4/27	MI cable tools to drill in. T.D. 1734'	"
5/3	Total Depth 1734' 7" set 1733' Bailing mud.	(Tel)
5/6	Drilled in Sat. Oil 1737-46' Filled up 65' in 40 hours No water Will tube, acidize, & test.	
5/9	Miss. 1731' 7" set 1733' Total Depth 1747' 65' oil in 40 hours 2000 gallons acid Testing	(Tel)
5/11	Completed for 20 bbls. 5-10-46	"

OVER

1946

5/15 Miss. 1731
7" @ 1733
2000 acid.
TD 1747'
Pump 20 Pot.
Grav. 38.0

COMPLETED

KANSAS Kansas Pool Name Virgil

Map No. 16 Sec. 14 Twp. 24 R. 12W

Well No. 25 George Wayham


Mid-Continent Petroleum Corp.
Company

FIRST REPORT

Contractor

SE SW SE

SECTION PLAT

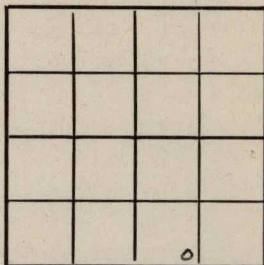

 Ft. from N. Line

330 Ft. from S. Line

 Ft. from E. Line

990 Ft. from W. Line

Greenwood County

Location

Rig up

Drilling and Remarks:

9 5/8" @ 21'

Drlg. 185'

RECORD

Cased in., ft.

Sand

Gas

Oil

Total Depth

PRODUCTION

1st 24 hrs. Nat.

1st 24 hrs. after shot

Gas Cu. Ft.

Dry Hole

Abandoned

Date

APR 1 7 1946 19

S. J. LEWIS

Scout

KANSASKansas Pool Name Virgil PoolMap No. 14 Sec. 14 Twp. 24 R. 12EWell No. 25 WayhamMid-Continent Petroleum Corp. Company**COMPLETED**

Contractor

SE SW SE

SECTION PLAT

 Ft. from N. Line330 Ft. from S. Line Ft. from E. Line990 Ft. from W. LineGreenwood CountyLocation Rig up

Drilling and Remarks:

Miss 1781
7" @ 1783,
2000 acid
Pump 20 ft

*38%₄***RECORD**Cased in., ft.Sand Gas Oil Total Depth 1247**PRODUCTION**1st 24 hrs. Nat. 1st 24 hrs. after shot Gas Cu. Ft.Dry Hole Abandoned

Date

MAY 15 1946

19

S. J. LEWIS

Scout