


Section 2 Township 28 Range 4-E

Well No. #1, Ambler

Company H & M Drilling Company

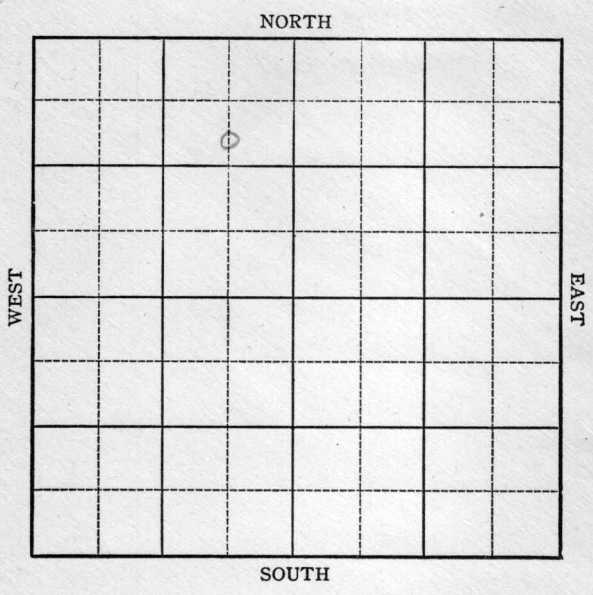

Sec. 2 Twp. 28 R. 4E

Well No. 1 Amblar Farm

H & M Drlg Company


Miscellaneous

990 Ft. from N. Line

Ft. from S. Line

660 Ft. from E. Line

Ft. from W. Line

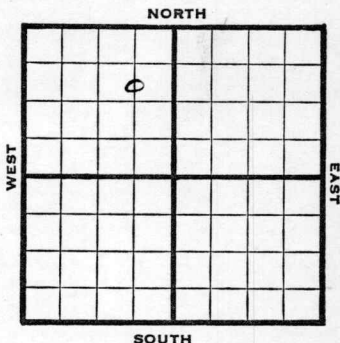

C S L NE NW

1946 REPORT

11/13 Machine
All Wells Abandoned

11/20 Mach

11/27 Drlg 825'

12/3 12" @ 775'
Drlg 1390'

12/10 KC 2069'
8" @ 2070'
Drlg 2085'

12/18 K C 2069'
8" @ 2070'
TD 2100'
1000 Acid
Pump 35 Pot
38 Grav.

COMPLETED

Map No. 11 Sec. 2 Twp. 28 R. 4E

Well No. 1 Amblar

H & M Drlg. Company

FIRST REPORT Contractor

C S L NE NW

SECTION PLAT

990 Ft. from N. Line

_____ Ft. from S. Line

660 Ft. from E. Line

_____ Ft. from W. Line

	60		

Butler County

Location _____

Rig up _____

Drilling and Remarks:

Machine
All wells
abandoned

RECORD

Cased _____ in., _____ ft.

Sand _____

Gas _____

Oil _____

Total Depth _____

PRODUCTION

1st 24 hrs. Nat. _____

1st 24 hrs. after shot _____

Gas _____ Cu. Ft.

Dry Hole _____

Abandoned _____

Date

NOV 13 1946

19

S. J. LEWIS

Scout

Map No. 11 Sec. 2 Twp. 28 R. 4E

Well No. 1 Amblar

H & M Drlg. Company

COMPLETED Contractor

C S L NE NW

SECTION PLAT

990 Ft. from N. Line

_____ Ft. from S. Line

660 Ft. from E. Line

_____ Ft. from W. Line

Butler County

RECORD

Location _____

Cased _____ in., _____ ft.

Rig up _____

Sand _____

Drilling and Remarks:

Gas _____

KA 2069

Oil _____

8" @ 2070

Total Depth 2100

1000 acid

Pump 850 ft

PRODUCTION

1st 24 hrs. Nat. _____

1st 24 hrs. after shot _____

Gas _____ Cu. Ft.

Dry Hole _____

Abandoned _____

380 ft

Date

DEC 1 8 1946 19

S. J. LEWIS Scout