KANSAS

FORM 51 10M 8-47


Butler

Section 2 Township 28 Range 4E

Well No. 2 Amber (Ambler)

Company H. M. Drlg.

Misc.

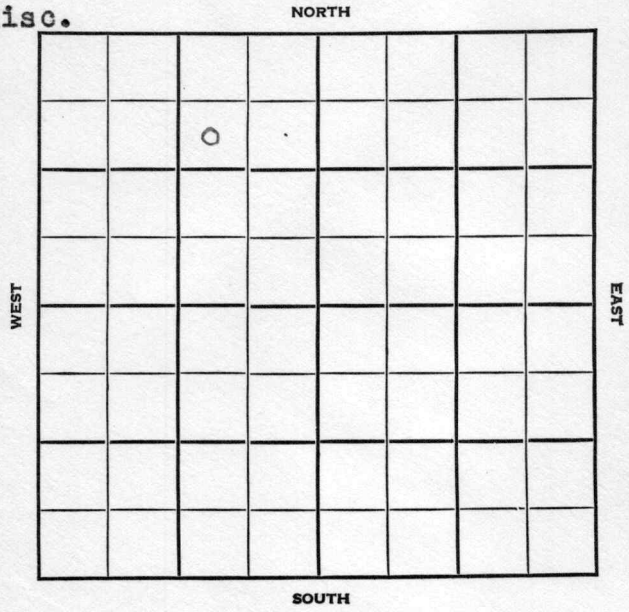

FORM 252-A
5M 9-47 PETROL

KANSAS Butler

Sec. 2 Twp. 28 R. 4E

Well No. #2 Amber Farm
H.M. Drlg.
Company

Misc.


990 Ft. from N. Line

Ft. from S. Line

990 Ft. from E. Line

Ft. from W. Line

SW NE NW

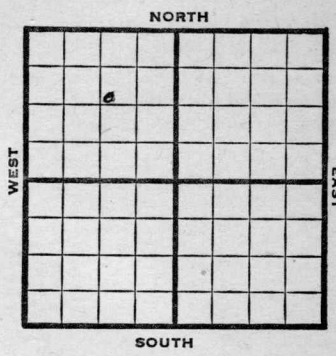

1947	REPORT
10/22	Location
10/29	Spud
11/5	12" @ 755' Drlg. 1090'
11/12	Lansing 1753' Drlg. 1905 '
11/19	"
11/25	Simpson Sd. 2614' TD 2622' 5" @ 2601' 900' oil 5 hrs.
12/3	"
12/10	10 Qts. 2622 CO
12/17	Water.
12/23	Simp. 2614' 5" @ 2601' Pump 50 oil / 25W Pot 38.0 Gr. TD 2622'

COMPLETED

Form 26 200 Bks. 10-46 Petrol

Kansas Misc.

Map No. _____ Sec. 2 Twp. 28 R. 4E

Well No. 2 Amber

H. M. Drlg. Company

FIRST REPORT Contractor

SW NE NW


990 Ft. from N. Line

_____ Ft. from S. Line

990 Ft. from E. Line

_____ Ft. from W. Line

SECTION PLAT

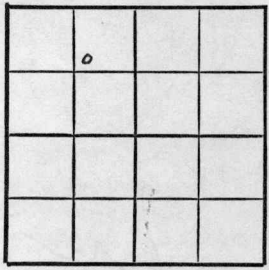

Butler County

Location x

Rig up

Drilling and Remarks:

RECORD

Cased _____ in., _____ ft.

Sand

Gas

Oil

Total Depth

PRODUCTION

1st 24 hrs. Nat.

1st 24 hrs. after shot

Gas _____ Cu. Ft.

Dry Hole

Abandoned

Date

OCT 22 1947 19 S. J. LEWIS Scout

Form 26 200 Bks. 10-46 Petrol

Kansas

Miscellaneous

Map No. 11 Sec. 2 Twp. 28 R. 4E

Well No. 2 Amber

H. & M. Drlg. Company

COMPLETE Contractor

SW NE NW


990 Ft. from N. Line

Ft. from S. Line

990 Ft. from E. Line

Ft. from W. Line

SECTION PLAT

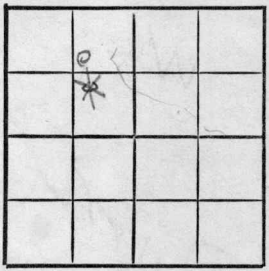

Butler County

Location

Rig up

Drilling and Remarks:

Surf 261 ft

5" @ 2601

Surf 50 oil + 25 W

85 - G

RECORD

Cased in., ft.

Sand

Gas

Oil

Total Depth 2622

PRODUCTION

1st 24 hrs. Nat.

1st 24 hrs. after shot

Gas Cu. Ft.

Dry Hole

Abandoned

Date

DEC 23 1947 19 S. J. LEWIS Scout