


Section 2 Township 28 Range 4E

Well No. 3 Amber *(Ambler)*

Company H & M. Dlg.

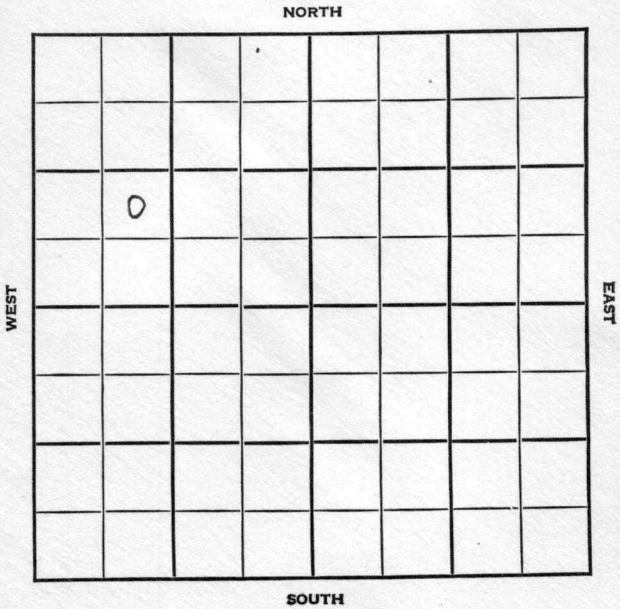

Sec. 2 Twp. 28 R. 4E

Well No. #3 Amber Farm

H. & M. Drlg. Company

Misc.


           Ft. from N. Line

990 Ft. from S. Line

           Ft. from E. Line

990 Ft. from W. Line

NE SW NW

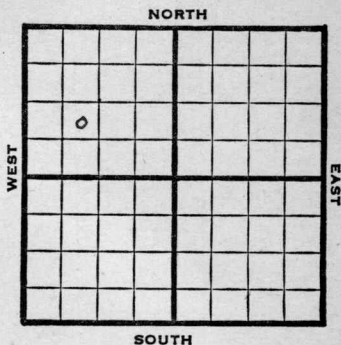

1947 Elev. 1295' REPORT

12/23 Location

12/30 Drlg. 285'

1948  
1/7 12" @ 712'  
Drlg. 1200'

1/14 10" @ 1735'  
Lamsing 1752'  
Dr lg 2035'

1/21 KC 2110'  
8" @ 2330'  
Drlg. 2560'

1/26 Wilcox 2612-25'  
TD 2625'  
500 oil  
5" @ 2615'

2/4 "

2/11 Wilcox 2612'  
5" @ 2615'  
Pump 35 Pot  
38.0 Gr.  
TD 2617'  
Comp.

COMPLETED

Map No. \_\_\_\_\_ Sec. 2 Twp. 28 R. 4E

Well No. 3 Amber

H. & M. Drlg. Company

FIRST REPORT

Contractor

NE SW NW

SECTION PLAT

\_\_\_\_\_ Ft. from N. Line

990 Ft. from S. Line

\_\_\_\_\_ Ft. from E. Line

990 Ft. from W. Line


Butler County

RECORD

Location X

Cased \_\_\_\_\_ in., \_\_\_\_\_ ft.

Rig up \_\_\_\_\_

Sand \_\_\_\_\_

Drilling and Remarks:

Gas \_\_\_\_\_

Oil \_\_\_\_\_

Total Depth \_\_\_\_\_

PRODUCTION

1st 24 hrs. Nat. \_\_\_\_\_

1st 24 hrs. after shot \_\_\_\_\_

Gas \_\_\_\_\_ Cu. Ft.

Dry Hole \_\_\_\_\_

Abandoned \_\_\_\_\_

Date

DEC 23 1947 19

S. J. LEWIS Scout

Map No. 11 Sec. 2 Twp. 28 R. 4E

Well No. 3 Amber

H. & M. Drlg. Company

COMPLETE

Contractor

NE SW NW

*E 11295*

SECTION PLAT

o			

\_\_\_\_\_ Ft. from N. Line  
990 Ft. from S. Line  
 \_\_\_\_\_ Ft. from E. Line  
990 Ft. from W. Line

Butler County

Location \_\_\_\_\_

Rig up \_\_\_\_\_

Drilling and Remarks:

*Wilcox 2612*  
*5' @ 2615*  
*Pump 35 B*

*25° SW*

RECORD

Cased \_\_\_\_\_ in., \_\_\_\_\_ ft.  
 Sand \_\_\_\_\_  
 Gas \_\_\_\_\_  
 Oil  \_\_\_\_\_  
 Total Depth 2617

PRODUCTION

1st 24 hrs. Nat. \_\_\_\_\_  
 1st 24 hrs. after shot \_\_\_\_\_  
 Gas \_\_\_\_\_ Cu. Ft.  
 Dry Hole \_\_\_\_\_  
 Abandoned \_\_\_\_\_

Date

FEB 11 1948 19

S. J. LEWIS Scout