


Section 2 Township 28 Range 4E

Well No. 4 Ambler

Company H & M Drlg.

Misc.
NORTH

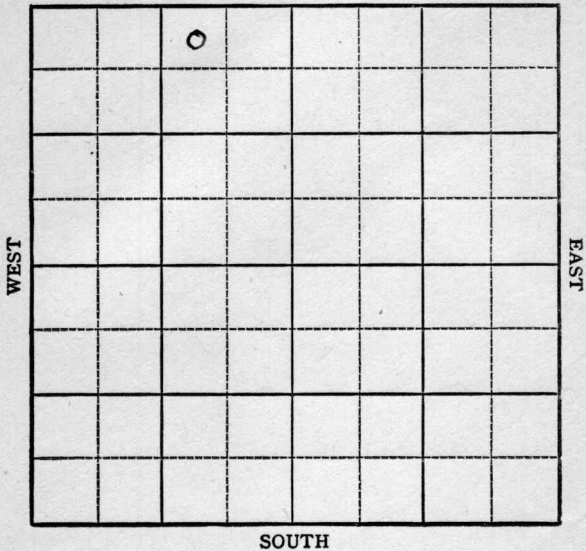

Sec. 2 Twp. 28 R. 4-E ✓

Well No. #4 Ambler Farm

H & M Drlg Company
Miscellaneous


330 Ft. from N. Line

 Ft. from S. Line

990 Ft. from E. Line

 Ft. from W. Line

NW NE NW

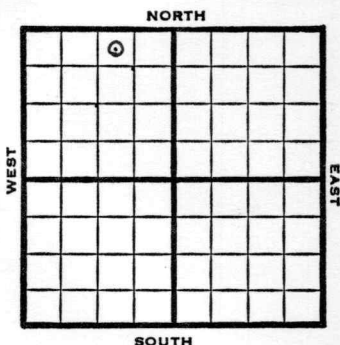

1948 # Elev. 1291' REPORT

9/29	Location
10/6	Drlg. 70'
10/13	12" @ 740' Drlg. 1300'
10/19	Drlg. 1970' 10" @ 1750'
10/26	Bart 2611' Drlg. 2616' SO
11/3	Bart 2611' 5" @ 2603' Pump 25 oil Pot. Gr. 39° TD 2621'

COMPLETED

Map No. _____ Sec. 2 Twp. 28 R. 4EWell No. 4 AmblerH. & M. Drlg. Company

FIRST REPORT

Contractor

NW NE NW

SECTION PLAT

	°		

330 Ft. from N. Line

_____ Ft. from S. Line

990 Ft. from E. Line

_____ Ft. from W. Line

Butler CountyLocation X

Rig up _____

Drilling and Remarks:

RECORD

Cased _____ in., _____ ft.

Sand _____

Gas _____

Oil _____

Total Depth _____

PRODUCTION

1st 24 hrs. Nat. _____

1st 24 hrs. after shot _____

Gas _____ Cu. Ft.

Dry Hole _____

Abandoned _____

Date

SEP 29 1948

19

S. J. LEWIS

Scout

Map No. 11 Sec. 2 Twp. 28 R. 4E

Well No. 4 Ambler

H. & M. Drlg. Company

COMPLETE

Contractor

NW NE NW


E 11291
SECTION PLAT

330 Ft. from N. Line

Ft. from S. Line

990 Ft. from E. Line

Ft. from W. Line

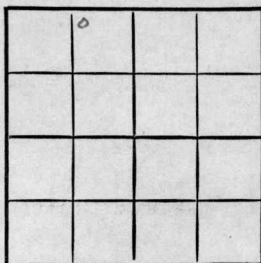

Butler County

RECORD

Location _____

Rig up _____

Drilling and Remarks:

Cased _____ in., _____ ft.

Sand _____

Gas _____

Oil ☒

Total Depth 2641

PRODUCTION

1st 24 hrs. Nat. _____

1st 24 hrs. after shot _____

Gas _____ Cu. Ft.

Dry Hole _____

Abandoned _____

Date

NOV 3 1948 19

S. J. LEWIS

Scout